

MISSISSIPPI DEPARTMENT OF NATURAL RESOURCES

Bureau of Land and Water Resources

Southport Mall

P.O. Box 10631

Jackson, Mississippi 39209

WATER WELL DRILLERS LOG

P. River
U 23A
5

6-4-92 date well completed Bud Penton Water Well firm name Pearl River county well located

LANDOWNER: Jonny Stewart
400 Dumas Baily Rd.

Carriere Ms 39426
(mailing address)

WELL LOCATION:
sec. 29 T. 5 N. R. 17 E
S W
5 miles west of Picayune
(distance) (direction) (nearest town)

WELL PURPOSE: HOME
(home, irrigation, municipal, industrial)


WELL COMPLETION DATA:

- (1) diameter (inches) 2.5"
- (2) total depth (feet) 310
- (3) static water level (feet) 46' ^{below} _{above} top of ground.
- (4) casing PVC 300'
(material) (depth)
2" If telescope see back.
(size)
- (5) screen 10' 300'
(length) (depth to top)
2" PVC
(size) (material)
- (6) pump 1/2 6
(HP) (yield gpm)
electric
(type power)
- (7) electric log NO
(yes or no)

(organization running log)

(8) how well bottom plugged sandshale

description of formations encountered	from	to
White shale	0	22
White sand	22	60
Blue shale	60	190
Blue sand	190	310

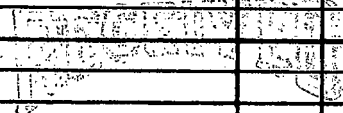


APR 28 1993

Dept. of Environmental Quality
Office of Land & Water Resources

DRILLERS REMARKS:

If well telescopes please sketch and show depths.

GROUND LEVEL

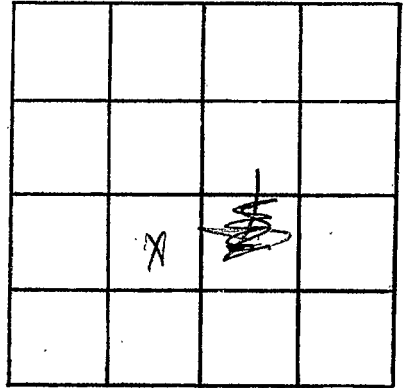

SECTION 29

Please indicate well location X.

ADDITIONAL INFORMATION

If more than one screen,
show locations of each on sketch.