

MISSISSIPPI DEPARTMENT OF NATURAL RESOURCES

Bureau of Land and Water Resources

COUNTY WELL LOCATED
Pearl River

WELL NUMBER CODED
U 2149

DATE WELL COMPLETED
1-23-96

PERMIT NUMBER

NAME OF DRILLING FIRM
Walker's Welding & Repair

P.O. Box 10631
Jackson, Mississippi 39209
WATER WELL DRILLERS LOG

NAME & MAILING ADDRESS OF LANDOWNER
Thomas Chance

18 Watts Rd.

Picayune, Miss.

WELL LOCATION: SEC TOWNSHIP RANGE
3 5 N 17 W

DISTANCE DIRECTION NEAREST TOWN
1 Miles *N* of *Picayune*

OTHER LANDMARK

WELL PURPOSE: Home, Irrigation, Municipal, Industrial, Fish Pond, etc.
Home

PUMP DATA

PUMP TYPE (Circle One):
Submersible, Turbine, Jet, Flowing Well,
Other (Describe) _____

POWER TYPE (Circle One):
 Electric, Tractor, Diesel, Gasoline, Butane,
Other (Describe) _____

Pump Capacity (GPM) No. of Stages Setting Depth
6 2 40' FT.

PUMP TEST

Well yielded _____ GPM with
a drawdown of _____ ft.
after _____ hours of pumping

WELL DATA

Well Depth Casing Diameter (In.) Casing Length (Ft.)
352' 2" 332'

Type of Casing Hole Depth Depth to Static Water Level
PVC 30'

TYPE OF COMPLETION: (Circle One or More):
Gravel Packed, Underreamed, Telescoped,
Natural Development, Open Hole, Other
(Describe) _____

Top of Lap Pipe or Reduction in Casing
FEET IF TELESCOPED OR MORE THAN ONE SCREEN: USE BACK PAGE

LOG DATA

TYPE OF LOG RUN (Circle One): No Log Run,
Electric, Gamma Ray, Density, Sonic, Neutron,
Other (Describe) _____

Name of Organization Running Log

SCREEN DATA

Diameter - Inches Length - Feet Slot Size - Inches
2" 20' .010

Screen Type Depth to Bottom - Feet
PVC

GEOLOGIC DATA (Office Use Only)

Surface Elev.	Geologic Unit	Unit Thickness	Depth to Top
Subs. SWL	Date	Analysis	Aquifer Test

Driller's Remarks

RECEIVED


DESCRIPTION OF FORMATIONS ENCOUNTERED	FROM	TO	FORMATIONS (Continued)	
			FROM	TO
<i>Red clay & sand</i>	<i>0</i>	<i>18'</i>	FEB 23 1996	
<i>Blue Clay</i>	<i>18'</i>	<i>300'</i>		
<i>Sand & small gravel</i>	<i>300'</i>	<i>352'</i>		

Dept. of Environmental Quality
Office of Land & Water Resources

IF MORE SPACE IS NEEDED, USE BACK

If well telescopes please
sketch and show depths.

GROUND LEVEL

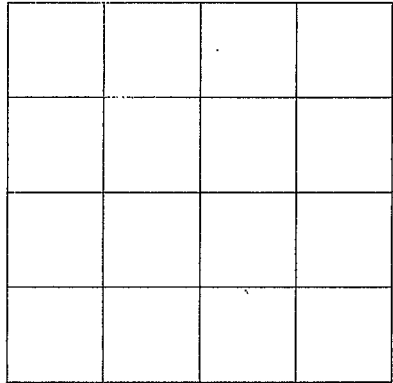

SECTION _____

Please indicate well location X.

ADDITIONAL INFORMATION

If more than one screen,
show location of each on sketch.