

# MISSISSIPPI DEPARTMENT OF NATURAL RESOURCES

Bureau of Land and Water Resources

COUNTY WELL LOCATED <i>Pearl River</i>	
WELL NUMBER <i>A 2150</i>	CODED
DATE WELL COMPLETED <i>2-16-96</i>	

PERMIT NUMBER
NAME OF DRILLING FIRM <i>Walbers Welding &amp; Repair</i>

P.O. Box 10631  
Jackson, Mississippi 39209  
**WATER WELL DRILLERS LOG**

NAME & MAILING ADDRESS OF LANDOWNER <i>John Wilkerson</i>		
<i>Hwy 43 S</i>		
<i>Picayune, Miss.</i>		
WELL LOCATION:	SEC	TOWNSHIP RANGE
	<i>32</i>	<i>5 N 17 E</i>
DISTANCE	DIRECTION	NEAREST TOWN
<i>3</i> Miles	<i>N</i>	of <i>Picayune</i>
OTHER LANDMARK		
WELL PURPOSE: <input checked="" type="radio"/> Home, <input type="radio"/> Irrigation, <input type="radio"/> Municipal, <input type="radio"/> Industrial, <input type="radio"/> Fish Pond, etc.		

<b>PUMP DATA</b>		
PUMP TYPE (Circle One): Submersible, Turbine, <input checked="" type="radio"/> Jet, <input type="radio"/> Flowing Well, Other (Describe) _____		
POWER TYPE (Circle One): <input checked="" type="radio"/> Electric, <input type="radio"/> Tractor, <input type="radio"/> Diesel, <input type="radio"/> Gasoline, <input type="radio"/> Butane, Other (Describe) _____		
Pump Capacity (GPM) <i>6</i>	No. of Stages <i>2</i>	Setting Depth <i>60'</i> FT.
PUMP TEST		
Well yielded _____ GPM with a drawdown of _____ ft. after _____ hours of pumping		


<b>WELL DATA</b>		
Well Depth <i>350'</i>	Casing Diameter (In.) <i>2"</i>	Casing Length (Ft.) <i>330</i>
Type of Casing <i>PVC</i>	Hole Depth <i>350'</i>	Depth to Static Water Level <i>29'</i>
TYPE OF COMPLETION: (Circle One or More): Gravel Packed, Underreamed, Telescoped, Natural Development, Open Hole, Other (Describe) _____		
Top of Lap Pipe or Reduction in Casing		
FEET <input type="checkbox"/> IF TELESCOPED OR MORE THAN ONE SCREEN: USE BACK PAGE		

<b>LOG DATA</b>	
TYPE OF LOG RUN (Circle One): No Log Run, Electric, Gamma Ray, Density, Sonic, Neutron, Other (Describe) _____	
Name of Organization Running Log	

<b>SCREEN DATA</b>		
Diameter - inches <i>2"</i>	Length - Feet <i>20'</i>	Slot Size - inches <i>.010</i>
Screen Type <i>PVC</i>		Depth to Bottom - Feet

<b>GEOLOGIC DATA (Office Use Only)</b>			
Surface Elev.	Geologic Unit	Unit Thickness	Depth to Top
Subs. SWL	Date	Analysis	Aquifer Test

Driller's Remarks

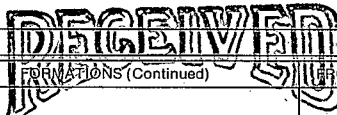


DESCRIPTION OF FORMATIONS ENCOUNTERED	FROM	TO	FORMATIONS (Continued)	FROM	TO
<i>Orange clay</i>	<i>0</i>	<i>18'</i>	<b>FEB 23 1996</b>  <b>Dept. of Environmental Quality</b> <b>Office of Land &amp; Water Resources</b>		
<i>Gravel</i>	<i>18'</i>	<i>90'</i>			
<i>Blue Clay</i>	<i>90'</i>	<i>314'</i>			
<i>Sand &amp; Black Rock</i>	<i>314'</i>	<i>350'</i>			

IF MORE SPACE IS NEEDED, USE BACK

If well telescopes please  
sketch and show depths.

GROUND LEVEL

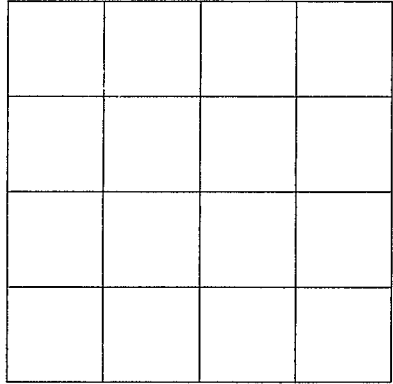

SECTION \_\_\_\_\_

Please indicate well location X.

ADDITIONAL INFORMATION

If more than one screen,  
show location of each on sketch.