

MISSISSIPPI DEPARTMENT OF NATURAL RESOURCES

Bureau of Land and Water Resources

COUNTY WELL LOCATED <i>Pearl River</i>	
WELL NUMBER <i>U 2152</i>	CODED
DATE WELL COMPLETED <i>7-18-96</i>	

PERMIT NUMBER
NAME OF DRILLING FIRM <i>Walsh's Wellboring & Repair</i>

P.O. Box 10631
Jackson, Mississippi 39209
WATER WELL DRILLERS LOG

NAME & MAILING ADDRESS OF LANDOWNER <i>Donald Stockstill</i>			
<i>174 Liberty Rd.</i>			
<i>Picayune, Miss</i>			
WELL LOCATION: SEC	TOWNSHIP	RANGE	
<i>33</i>	<i>5</i>	<i>N 11</i>	<i>W</i>
DISTANCE	DIRECTION	NEAREST TOWN	
<i>2</i> Miles	<i>N</i>	of <i>Picayune</i>	
OTHER LANDMARK			
WELL PURPOSE: <input checked="" type="radio"/> Home, <input type="radio"/> Irrigation, <input type="radio"/> Municipal, <input type="radio"/> Industrial, <input type="radio"/> Fish Pond, etc.			

PUMP DATA		
PUMP TYPE (Circle One): Submersible, Turbine, <input checked="" type="radio"/> Jet, Flowing Well, Other (Describe) _____		
POWER TYPE (Circle One): <input checked="" type="radio"/> Electric, <input type="radio"/> Tractor, <input type="radio"/> Diesel, <input type="radio"/> Gasoline, <input type="radio"/> Butane, Other (Describe) _____		
Pump Capacity (GPM)	No. of Stages	Setting Depth
<i>6</i>	<i>2</i>	<i>40'</i> FT.
PUMP TEST		
Well yielded _____ GPM with a drawdown of _____ ft. after _____ hours of pumping		

WELL DATA		
Well Depth <i>306'</i>	Casing Diameter (In.) <i>2"</i>	Casing Length (Ft.) <i>286'</i>
Type of Casing <i>PVC</i>	Hole Depth <i>306'</i>	Depth to Static Water Level <i>24'</i>
TYPE OF COMPLETION: (Circle One or More): <input checked="" type="radio"/> Gravel Packed, <input type="radio"/> Underreamed, <input type="radio"/> Telescoped, <input checked="" type="radio"/> Natural Development, <input type="radio"/> Open Hole, <input type="radio"/> Other		
Top of Lap Pipe or Reduction in Casing		
FEET <input type="checkbox"/> IF TELESCOPED OR MORE THAN ONE SCREEN: USE BACK PAGE		


LOG DATA	
TYPE OF LOG RUN (Circle One): No Log Run, Electric, Gamma Ray, Density, Sonic, Neutron, Other (Describe) _____	
Name of Organization Running Log	

SCREEN DATA		
Diameter - Inches <i>2"</i>	Length - Feet <i>20'</i>	Slot Size - Inches <i>.010</i>
Screen Type <i>PVC</i>	Depth to Bottom - Feet <i>306'</i>	

GEOLOGIC DATA (Office Use Only)			
Surface Elev.	Geologic Unit	Unit Thickness	Depth to Top
Subs. SWL	Date	Analysis	Aquifer Test

Driller's Remarks

DESCRIPTION OF FORMATIONS ENCOUNTERED	FROM	TO
<i>Red sandy clay</i>	<i>0</i>	<i>36'</i>
<i>Gravel and fine sand</i>	<i>36'</i>	<i>90'</i>
<i>Gray clay & sand</i>	<i>90'</i>	<i>262'</i>
<i>Coarse sand and</i>	<i>262'</i>	<i>306'</i>
<i>Black Rock</i>		

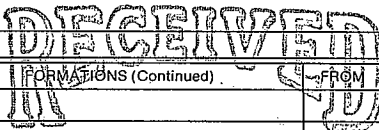

JUL 23 1996

Dept. of Environmental Quality
Office of Land & Water Resources

FORMATIONS (Continued)	FROM	TO

IF MORE SPACE IS NEEDED, USE BACK

If well telescopes please
sketch and show depths.

GROUND LEVEL

SECTION _____

Please indicate well location X.

ADDITIONAL INFORMATION

If more than one screen,
show location of each on sketch.
