

MISSISSIPPI DEPARTMENT OF NATURAL RESOURCES

Bureau of Land and Water Resources

P.O. Box 10631

Jackson, Mississippi 39209

WATER WELL DRILLERS LOG

COUNTY WELL LOCATED <i>Pearl River</i>	
WELL NUMBER <i>A 2154</i>	CODED
DATE WELL COMPLETED <i>10-30-96</i>	

PERMIT NUMBER
NAME OF DRILLING FIRM <i>Walker's Welding & Repair</i>

NAME & MAILING ADDRESS OF LANDOWNER <i>Harvey Bryant</i>			
<i>11 Watts Road</i>			
<i>Picayune, Miss.</i>			
WELL LOCATION: SEC	TOWNSHIP	RANGE	
<i>3</i>	<i>5</i>	<i>N</i>	<i>17</i>
DISTANCE		DIRECTION	NEAREST TOWN
<i>2</i> Miles		<i>N</i>	of <i>Picayune</i>
OTHER LANDMARK			
WELL PURPOSE: <input checked="" type="radio"/> Home Irrigation, <input type="radio"/> Municipal, <input type="radio"/> Industrial, <input type="radio"/> Fish Pond, etc.			

PUMP DATA		
PUMP TYPE (Circle One): Submersible, Turbine, <input checked="" type="radio"/> Jet, <input type="radio"/> Flowing Well, Other (Describe) _____		
POWER TYPE (Circle One): <input checked="" type="radio"/> Electric, <input type="radio"/> Tractor, <input type="radio"/> Diesel, <input type="radio"/> Gasoline, <input type="radio"/> Butane, Other (Describe) _____		
Pump Capacity (GPM) <i>6</i>	No. of Stages <i>1</i>	Setting Depth <i>25'</i> FT.
PUMP TEST		
Well yielded _____ GPM with a drawdown of _____ ft. after _____ hours of pumping		

WELL DATA		
Well Depth <i>360'</i>	Casing Diameter (In.) <i>2"</i>	Casing Length (Ft.) <i>340'</i>
Type of Casing <i>PVC</i>	Hole Depth <i>360"</i>	Depth to Static Water Level <i>18"</i>
TYPE OF COMPLETION: (Circle One or More): <input checked="" type="radio"/> Gravel Packed, <input type="radio"/> Underreamed, <input type="radio"/> Telescoped, <input checked="" type="radio"/> Natural Development, <input type="radio"/> Open Hole, <input type="radio"/> Other (Describe) _____		
Top of Lap Pipe or Reduction in Casing FEET <input type="checkbox"/> IF TELESCOPED OR MORE THAN ONE SCREEN: USE BACK PAGE		

LOG DATA	
TYPE OF LOG RUN (Circle One): <input type="radio"/> No Log Run, <input type="radio"/> Electric, <input type="radio"/> Gamma Ray, <input type="radio"/> Density, <input type="radio"/> Sonic, <input type="radio"/> Neutron, Other (Describe) _____	
Name of Organization Running Log	

SCREEN DATA		
Diameter - Inches <i>2"</i>	Length - Feet <i>20'</i>	Slot Size - Inches <i>.010</i>
Screen Type <i>PVC</i>		Depth to Bottom - Feet <i>360'</i>


GEOLOGIC DATA (Office Use Only)			
Surface Elev.	Geologic Unit	Unit Thickness	Depth to Top
Subs. SWL	Date	Analysis	Aquifer Test
Driller's Remarks <div style="text-align: center; font-size: 2em; font-weight: bold; opacity: 0.5;">RECEIVED</div> <div style="text-align: center; font-weight: bold;">NOV 04 1996</div>			

DESCRIPTION OF FORMATIONS ENCOUNTERED	FROM	TO	FORMATIONS (Continued)	FROM	TO
<i>Sandy Top Soil</i>	<i>0</i>	<i>10'</i>			
<i>Black Clay</i>	<i>10'</i>	<i>36'</i>			
<i>Blue Sandy Clay</i>	<i>36'</i>	<i>54'</i>			
<i>Blue Clay</i>	<i>54'</i>	<i>308'</i>			
<i>Coarse Sand & Gravel</i>	<i>308'</i>	<i>360'</i>			
IF MORE SPACE IS NEEDED, USE BACK					

Dept. of Environmental Quality
Office of Land & Water Resources

If well telescopes please sketch and show depths.

GROUND LEVEL

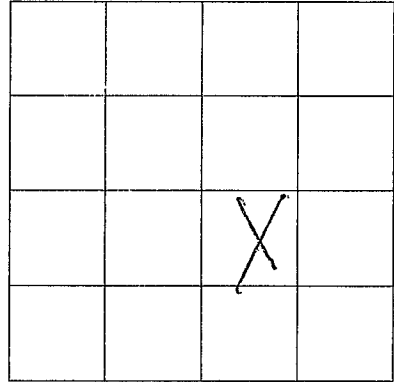

SECTION 3

Please indicate well location X.

ADDITIONAL INFORMATION

If more than one screen,
show location of each on sketch.