

MISSISSIPPI DEPARTMENT OF ENVIRONMENTAL QUALITY

Office of Land and Water Resources

P. O. Box 10631
Jackson, MS 39289-0631
WATER WELL DRILLERS LOG

COUNTY WELL LOCATED IN Pearl River	
WELL NUMBER 0-2156	CODED
DATE WELL COMPLETED 5-13-00	

PERMIT NUMBER 0-519
NAME OF DRILLING FIRM Burge Well Service

NAME & MAILING ADDRESS OF LANDOWNER Jose Blasini 922 Timberlane Road Prayune, Mo			
WELL LOCATION: SEC	TOWNSHIP	RANGE	
33	5	17	E
DISTANCE	DIRECTION	NEAREST TOWN	
0 Miles	NORTH	PRAYUNE	
OTHER LANDMARK TIMBERLANE			
WELL PURPOSE: <input checked="" type="checkbox"/> Home Irrigation, <input type="checkbox"/> Municipal, <input type="checkbox"/> Industrial, <input type="checkbox"/> Fish Pond, etc.			

PUMP DATA		
PUMP TYPE (Circle One): Submersible, Turbine, <input checked="" type="radio"/> Jet, Flowing Well, Other (Describe) _____		
POWER TYPE (Circle One): <input checked="" type="radio"/> Electric, Tractor, Diesel, Gasoline, Butane, Other (Describe) _____ H/P _____		
Pump Capacity (GPM)	No. of Stages	Setting Depth
10	2	50 FT.
PUMP TEST		
Well yielded 10 GPM with a drawdown of _____ ft. after _____ hours of pumping		

WELL DATA		
Well Depth 340'	Casing Diameter (In.) 2	Casing Length (Ft.) 340'
Type of Casing PVC	Hole Depth 340'	Depth to Static Water Level 15'
TYPE OF COMPLETION: (Circle One or More): Gravel Packed, Underreamed, Telescoped, Natural Development, Open Hole, Other (Describe) AIR		
WELL GROUTED TO A DEPTH OF 10 FEET Type Grout (circle one): <input checked="" type="radio"/> Cement, <input type="radio"/> Bentonite, or Mix		

LOG DATA	
TYPE OF LOG RUN (Circle One): No Log Run, Electric, Gamma Ray, Density, Sonic, Neutron, Other (Describe) _____	
Name of Organization Running Log	

SCREEN DATA		
Diameter - Inches 2	Length - Feet 20'	Slot Size - Inches #8
Screen Type SLOT	Depth to Bottom - Feet 340	

GEOLOGIC DATA (Office Use Only)			
Surface Elev.	Geologic Unit	Unit Thickness	Depth to Top
Subs. SWL	Date	Analysis	Aquifer Test
Driller's Remarks pumps very well			
Top of Lap Pipe or Reduction in Casing FEET <input checked="" type="checkbox"/> TELESCOPED OR MORE THAN ONE SCREEN USE BACK PAGE			

DESCRIPTION OF FORMATIONS ENCOUNTERED:	FROM	TO	FORMATIONS (continued)	FROM	TO
CLAY	0	6			
DIRT + SAND	0	10			
SAND	10	25			
ROCK + SAND	25	45			
SAND	45	65			
BLUE CLAY	65	265			
FINE SAND BLUE	265	285			
BIGGER SAND	285	300			
BIG SAND	300	340			


Dept. of Environmental Quality
Office of Land & Water Resources

JUN 03 2000

IF MORE SPACE IS NEEDED, USE BACK

If well telescopes please sketch and show depths.

GROUND LEVEL

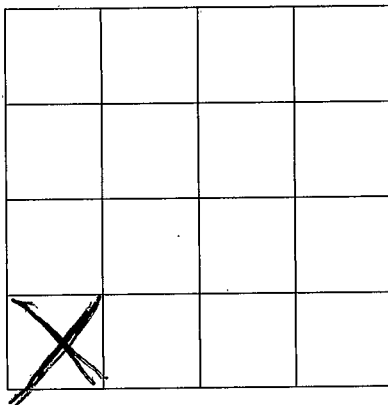

SECTION _____

Please indicate well location X.

ADDITIONAL INFORMATION

20' SCREEN

If more than one screen,
show location of each on sketch.