

WATER WELL DRILLERS LOG

7-27-64

Date: July 27, 1964, Driller: J. Beall County Pearl River (Name)

(1) Owner of Land: Edw. F. Montague (Name) Rt 1 Carriere Min (Address)

(2) Location: SW 1/4, NE 1/4, Sec. 23, T. 5 R. 16, 3 miles North of Cesar (distance) (direction) (Nearest Town)

(3) Topography: X (Hill) (Flat) (Level)

(4) Purpose of Well: Home (Domestic Irrigation, Municipal, Industrial, Other)


Description & Color of Materials Sand, Clay, Red Clay, Shell, etc.	Thick- ness Feet	Depth Feet
Red Mud + sand	105	105
Hard Blue mud	277	382
water sand	30	412

Information upon completion of well:

- (1) Diameter 2" x 1 1/4" inches.
- (2) Total Depth 412 feet.
- (3) Water Level 8 1/2 feet below top of ground.
- (4) Cased to _____, Size _____.
- (5) Screen: Size 1 1/4", Length 15'
- (6) Were any formations sealed against pollution?
_____ yes, _____ no.

If YES depth of formation _____
Why _____

Drillers Remarks: _____

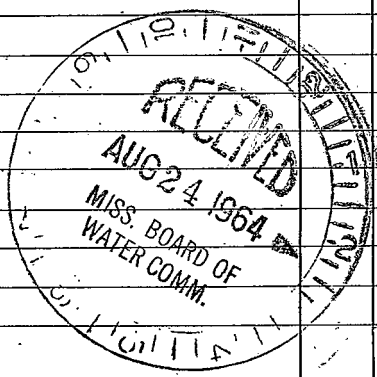

(Use Back Side)

Well No.

