

Pearl River
 V 2,
 10-24-68

MISSISSIPPI
 BOARD OF WATER COMMISSIONERS CODED
 416 North State Street
 Jackson, Mississippi 39201

CODED

WATER WELL DRILLERS LOG

10-24 1968 Penton Well Serv Pearl River
 date well completed firm name county well located

LANDOWNER: Cecil Palmer
 Rt. 2 Box 208A
 Carriere Miss
 (mailing address)

description of formations encountered	from	to
	Red Clay	0
Red sand	18	52
Red Clay	52	58
Red sand	58	110
White Clay	110	118
Blue Clay	118	175
Mud	175	202
Blue Clay	202	360
Grey sand	360	403


WELL LOCATION:
 sec. 26 T 5 S R 16 W
 1 miles West of Caesar
 (distance) (direction) (nearest town)

WELL PURPOSE: Home
 (home, irrigation, municipal, industrial)

WELL COMPLETION DATA: 4 1/2 Drilled

- (1) diameter (inches) 2"
- (2) total depth (feet) 403
- (3) static water level (feet) 67 below top of ground.
- (4) casing Calc 398 (material) (depth)
 2" (size) if telescope see back.
- (5) screen 5' 398 (length) (depth to top)
 2" (size) S. steel (material)
- (6) pump 1 9 (HP) (yield gpm)
 Elec (type power)
- (7) electric log NO (yes or no)
 (organization running log)
- (8) how well bottom plugged BW Valve

CODED

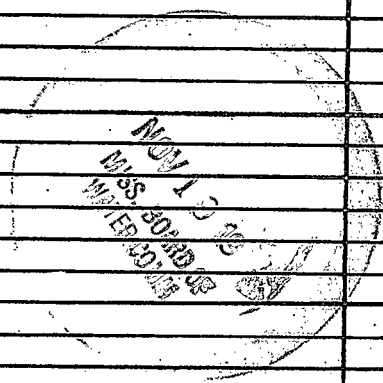

DRILLERS REMARKS:

If well telescopes please
sketch and show depths.

GROUND LEVEL

		X	

SECTION 26

Please indicate well location X.

ADDITIONAL INFORMATION

If more than one screen,
show locations of each on sketch.