

CODED

Pearl River  
V3  
10-26-68

MISSISSIPPI  
BOARD OF WATER COMMISSIONERS  
416 North State Street  
Jackson, Mississippi 39201

CODED

WATER WELL DRILLERS LOG

10-26 date well completed 1968 firm name Pearl River county well located

LANDOWNER: Leon M. Queen

303 N. Main

Picayune Miss.  
(mailing address)

WELL LOCATION:

sec. 24 T. 5 S. R. 16 W.  
1/2 miles West of Czesar  
(distance) (direction) (nearest town)

WELL PURPOSE: Home  
(home, irrigation, municipal, industrial)

WELL COMPLETION DATA: 6 1/2 Drilled

- (1) diameter (inches) 4" x 2"
- (2) total depth (feet) 409
- (3) static water level (feet) 83 below top of ground.

(4) casing Galv 399  
(material) (depth)

(size) If telescope see back.

(5) screen 10' 399  
(length) (depth to top)

012 2" S. Steel  
(size) (material)

(6) pump 1 30  
(HP) (yield gpm)

Elec  
(type power)

(7) electric log NO  
(yes or no)

(organization running log)

(8) how well bottom plugged Bw. Valve

DRILLERS REMARKS:


4" Submersible Pump

description of formations encountered

from to

Red Clay	0	26
" Sand	26	58
White Clay	58	72
Blue Clay	72	186
Mud	186	220
Blue Clay	220	368
Grey Sand	368	409

CODED

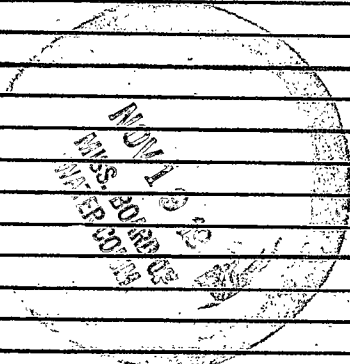

If well telescopes please sketch and show depths.

GROUND LEVEL

168' 4" C<sub>2</sub>L<sub>6</sub>  
10' screen 2 3/4" C<sub>2</sub>L<sub>6</sub>

.012 slot

	x		

SECTION 24

Please indicate well location X.

ADDITIONAL INFORMATION

If more than one screen, show locations of each on sketch.