

Pearl River
VR
3-21-69

MISSISSIPPI
 BOARD OF WATER COMMISSIONERS
 416 North State Street
 Jackson, Mississippi 39201

CODED

WATER WELL DRILLERS LOG

date well completed 3-21-69 firm name E. J. Waterwellson county well located Pearl River

LANDOWNER: Waldon Jones
New Orleans LA.
Anchor Lake
 (mailing address)

description of formations encountered	from	to
<u>Blue clay</u>	<u>0</u>	<u>84</u>
<u>Fluvial sand w/ clay sfs</u>	<u>84</u>	<u>100</u>
<u>Blue clay</u>	<u>100</u>	<u>135</u>
<u>meandering Brown sand</u>	<u>135</u>	<u>155</u>
<u>Blue clay</u>	<u>155</u>	<u>180</u>
<u>meandering sand</u>	<u>180</u>	<u>220</u>
<u>Coarse sand</u>	<u>220</u>	<u>280</u>

WELL LOCATION:
 sec. 8 T 5 N R 16 E
 S W
3 miles west of Carriere
 (distance) (direction) (nearest town)

WELL PURPOSE: Home
 (home, irrigation, municipal, industrial)

WELL COMPLETION DATA:

(1) diameter (inches) 4 5/8

(2) total depth (feet) 280

(3) static water level (feet) 27 below above top of ground.

(4) casing 2" Galv. 280
 (material) (depth)
 (size) if telescope see back.

(5) screen 5' 275
 (length) (depth to top)
2" S. Steel
 (size) (material)

(6) pump 1 920 G.P.H.
 (HP) (yield gpm)
Elect
 (type power)

(7) electric log NO
 (yes or no)

(organization running log)

(8) how well bottom plugged Shoe

CODED


APR 14 1969

DRILLERS REMARKS:
E. J. Waterwellson

MISS. Bd. of
 WATER COMMISSIONERS

If well telescopes please sketch and show depths.

GROUND LEVEL

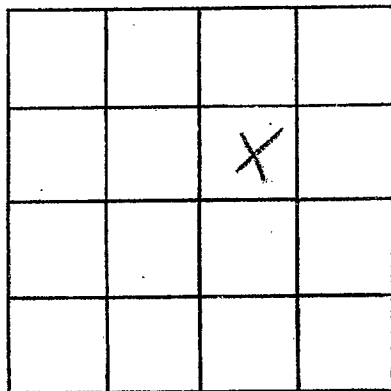

SECTION 8

Please indicate well location X.

ADDITIONAL INFORMATION

If more than one screen,
show locations of each on sketch.