

Pearl River
V9
69

MISSISSIPPI
BOARD OF WATER COMMISSIONERS
416 North State Street
Jackson, Mississippi 39201

CODED

WATER WELL DRILLERS LOG

date well completed 19 69 Penton well serv Pearl River firm name county well located

LANDOWNER: Doyle Cooper
Rt 3
Picayune Miss
(mailing address)

description of formations encountered	from	to
Red Clay	0	16
" sand	16	55
Black Clay	55	70
Blue Clay	70	130
yellow sand	130	152
Blue Clay	152	210
Grey sand	210	234

WELL LOCATION:
sec. 34 T. 5 S. R. 16 W.
5 miles NE of Picayune
(distance) (direction) (nearest town)

WELL PURPOSE: Home
(home, irrigation, municipal, industrial)

- WELL COMPLETION DATA:
- (1) diameter (inches) 2"
 - (2) total depth (feet) 234
 - (3) static water level (feet) 43 below ~~above~~ top of ground.
 - (4) casing Galv, 229,
(material) (depth)
2" if telescope see back.
(size)
 - (5) screen 5', 229
(length) (depth to top)
2", S. Steel
(size) (material)
 - (6) pump ✓ ✓
(HP) (yield gpm)
✓
(type power)
 - (7) electric log NO
(yes or no)

(organization running log)
 - (8) how well bottom plugged BW Value

DRILLERS REMARKS:


OCT 13 1969

MISS. BD. OF
WATER COMM.

012

If well telescopes please sketch and show depths.

GROUND LEVEL

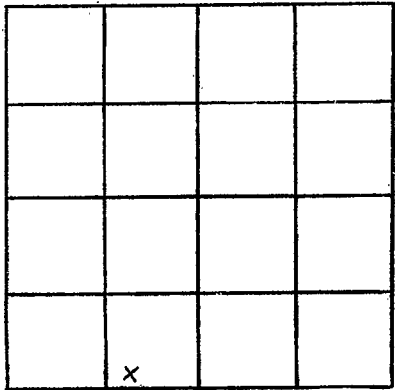

SECTION 5

Please indicate well location X.

ADDITIONAL INFORMATION

If more than one screen,
show locations of each on sketch.