

Pearl River
V 10
9-30-69

MISSISSIPPI
BOARD OF WATER COMMISSIONERS
416 North State Street
Jackson, Mississippi 39201

WATER WELL DRILLERS LOG

9-30 1969 Harold A. Poole Pearl River
date well completed firm name county well located

LANDOWNER: J K Sams
RT # 1, Chapin, Miss.
(mailing address)

description of formations encountered	from	to
Surface Clay	0	15
SAND	15	20
SILT	20	24
Clay	24	147
SAND	147	160

WELL LOCATION:
sec. 7 T. 5 N. R. 16 E.
15 miles S. of Poplarville
(distance) (direction) (nearest town)

WELL PURPOSE: Home
(home, irrigation, municipal, industrial)


- WELL COMPLETION DATA:
- (1) diameter (inches) 4
 - (2) total depth (feet) 160
 - (3) static water level (feet) 3 ^{below} _{above} top of ground.
 - (4) casing PVC 150
(material) (depth)
 - 2
(size) if telescope see back.
 - (5) screen 10 150
(length) (depth to top)
 - 2 PVC
(size) (material)
 - (6) pump _____ (HP) _____ (yield gpm)
(type power)
 - (7) electric log no
(yes or no)
 - _____
(organization running log)
 - (8) how well bottom plugged
Clayton Mack B.W.V.

DRILLERS REMARKS:

OCT 17 1969
MISS. Bd. OF
WATER COMM.

If well telescopes please sketch and show depths.

GROUND LEVEL

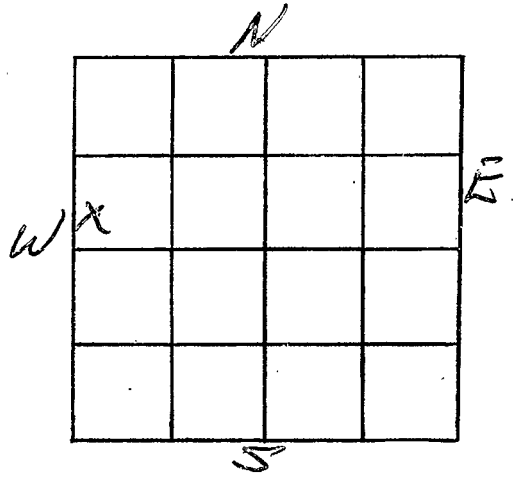

SECTION 7

Please indicate well location X.

ADDITIONAL INFORMATION

If more than one screen, show locations of each on sketch.