

Pearl River
VII
8-23-69

MISSISSIPPI
 BOARD OF WATER COMMISSIONERS CODED
 416 North State Street
 Jackson, Mississippi 39201

WATER WELL DRILLERS LOG

8-23 1969 Penlon Well Serv Pearl River
 date well completed firm name county well located

LANDOWNER: Elmer Wandrum

Rt. 2 Box 185
Carriere Miss
 (mailing address)

WELL LOCATION:

sec. 26 T. 5 R. 16
 S W
2 miles West of Caesar
 (distance) (direction) (nearest town)

WELL PURPOSE: Home
 (home, irrigation, municipal, industrial)

WELL COMPLETION DATA: 4 1/2" Drill

- (1) diameter (inches) 2"
- (2) total depth (feet) 190
- (3) static water level (feet) 59 below top of ground.
- (4) casing Galv, 185'
 (material) (depth)
2'
 (size) if telescope see back.
- (5) screen 5', 185'
 (length) (depth to top)
2", S. Steel
 (size) (material)
- (6) pump 1 7
 (HP) (yield gpm)
Elec
 (type power)
- (7) electric log No
 (yes or no)
 (organization running log)
- (8) how well bottom plugged BW, Valve

description of formations encountered

from to

Red Clay	0	18
SAND	18	38
White Clay	38	46
SAND	46	70
Blue Clay	70	170
Grey SAND	170	190


DRILLERS REMARKS:

SEP 18 1969

MISSISSIPPI BOARD OF WATER COMMISSIONERS

If well telescopes please sketch and show depths.

GROUND LEVEL

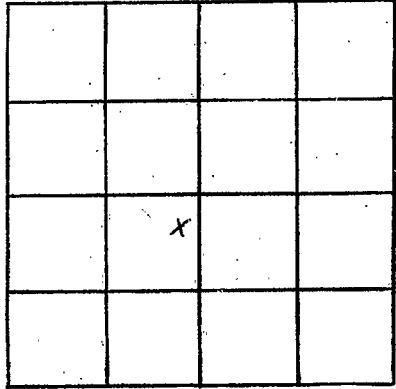

SECTION 26

Please indicate well location X.

ADDITIONAL INFORMATION

If more than one screen,
show locations of each on sketch.