

PEARL RIVER
 V 14
 10-20-69

MISSISSIPPI
 BOARD OF WATER COMMISSIONERS
 416 North State Street
 Jackson, Mississippi 39201

CODED

WATER WELL DRILLERS LOG

10-20 1969 *Penton Well Serv* Pearl River
 date well completed firm name county well located

LANDOWNER: *Norvil Pearson*
Rt. 2
Carriere Miss
 (mailing address)

| description of formations encountered | from | to |
|---------------------------------------|--------------|-----|
| | Surface Clay | 0 |
| Red Sand | 38 | 90 |
| White Clay | 90 | 118 |
| Blue Clay | 118 | 155 |
| Cerey Sand | 155 | 179 |

WELL LOCATION:
 sec. 13 T. 5 S. R. 16 W.
2 miles North of Caesar
 (distance) (direction) (nearest town)

WELL PURPOSE: Home
 (home, irrigation, municipal, industrial)

- WELL COMPLETION DATA:
- (1) diameter (inches) 2"
 - (2) total depth (feet) 179
 - (3) static water level (feet) 64 below top of ground.
 - (4) casing Coak, 174,
 (material) (depth)
2 if telescope see back.
 (size)
 - (5) screen 5', 174
 (length) (depth to top)
2", S. Steel
 (size) (material)
 - (6) pump 1 10
 (HP) (yield gpm)
Elec
 (type power)
 - (7) electric log NO
 (yes or no)
- (organization running log)
- (8) how well bottom plugged B.W. Value


NOV 13 1969

DRILLERS REMARKS:

MISS. BD. OF
 WATER COMMS

If well telescopes please sketch and show depths.

GROUND LEVEL

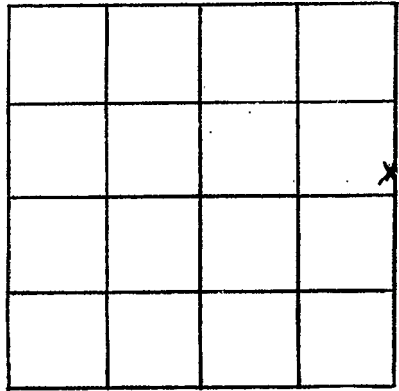

SECTION 13

Please indicate well location X.

ADDITIONAL INFORMATION

If more than one screen,
show locations of each on sketch.