

CODED

MISSISSIPPI BOARD OF WATER COMMISSIONERS
416 North State Street
Jackson, Mississippi 39201

PEARL RIVER
V 15
10-27-69

WATER WELL DRILLERS LOG

WELL LUMPKIN WELL DRILLING SERVICE
P. O. BOX 117
GARRETTSVILLE, MISS.

Pearl River
county well located

10-27 19 *69*
date well completed

LANDOWNER: *J.E. Siler*

Carriere

Route 2

(mailing address)

description of formations encountered

from

to

Surface clay

0 20

no good

20 60

Blue Clay

60 170

Good grey sand

170 195

WELL LOCATION:

sec. *17* T. *5* S. R. *16* W.
4 1/2 miles *East* of *Carriere*
(distance) (direction) (nearest town)

WELL PURPOSE: *home*
(home, irrigation, municipal, industrial)

WELL COMPLETION DATA:


- (1) diameter (inches) *2"*
- (2) total depth (feet) *195'*
- (3) static water level (feet) *90'* below above top of ground.
- (4) casing *galv.* (material), (depth),
2" if telescope see back. (size)
- (5) screen *5'* (length), (depth to top)
2" (size), *St. Steel* (material)
- (6) pump *1 HP* *450 gph* (HP) (yield gpm)
- (7) electric log *electric* (yes or no)
(organization running log)
- (8) how well bottom plugged *Johnson*
B.P. Valve

DRILLERS REMARKS:

MISS. WATER BOARD
1969

If well telescopes please
sketch and show depths.

GROUND LEVEL

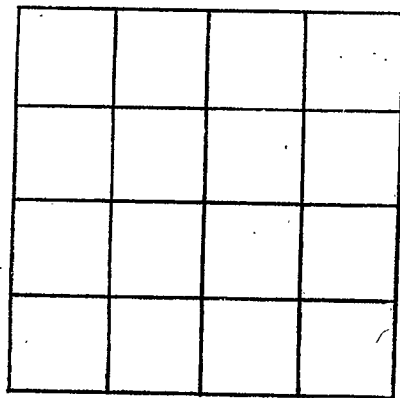

SECTION _____

Please indicate well location X.

ADDITIONAL INFORMATION

If more than one screen,
show locations of each on sketch.