

Pearl River  
V 17  
1-5-70

MISSISSIPPI  
 BOARD OF WATER COMMISSIONERS  
 416 North State Street  
 Jackson, Mississippi 39201

CODED  
 CODED

WATER WELL DRILLERS LOG


Jan 5, 1970 date well completed      S + S Well Works firm name      Pearl River county well located

LANDOWNER:	description of formations encountered	from	to
<u>Archester Cuevas Jr.</u>			
<u>Pt. 2, Box 191</u>	<u>Red Clay</u>	<u>2</u>	<u>15</u>
<u>Poplarville</u> (mailing address) <u>Miss.</u>	<u>Sand</u>	<u>15</u>	<u>25</u>
WELL LOCATION:	<u>Rock</u>	<u>25</u>	<u>31</u>
sec. <u>6</u> T. <u>5</u> N. <u>16</u> R. <u>7</u> E. <u>W</u>			
<u>16</u> miles <u>S</u> of <u>Poplarville</u>			
(distance) (direction) (nearest town)			
WELL PURPOSE: (home, irrigation, municipal, industrial)			
WELL COMPLETION DATA:			
(1) diameter (inches) <u>2 in.</u>			
(2) total depth (feet) <u>31</u>			
(3) static water level (feet) <u>16</u> <sup>below</sup> above top of ground.			
(4) casing <u>P.V.C.</u> <u>26</u> (material) (depth)			
(size) if telescope see back.			
(5) screen <u>5 ft.</u> <u>26 ft.</u> (length) (depth to top)			
<u>2 in.</u> <u>P.V.C.</u> (size) (material)			
(6) pump <u>3/4</u> <u>5</u> (HP) (yield gpm)			
<u>E</u> (type power)			
(7) electric log <u>NO</u> (yes or no)			
(organization running log)			
(8) how well bottom plugged <u>B.O.W.</u>			
DRILLERS REMARKS:			
<u>NONE</u>			

Jan 5 1970  
 MISSISSIPPI BOARD OF WATER COMMISSIONERS

If well telescopes please sketch and show depths.

GROUND LEVEL

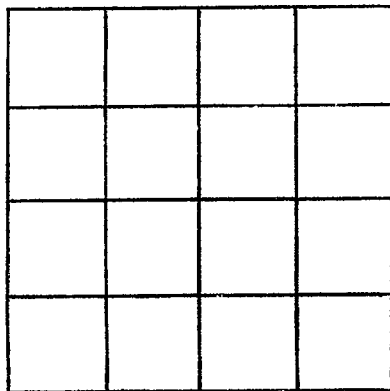

SECTION \_\_\_\_\_

Please indicate well location X.

ADDITIONAL INFORMATION

If more than one screen,  
show locations of each on sketch.