

Pearl River
 V18
 1-6-70

MISSISSIPPI
 BOARD OF WATER COMMISSIONERS
 416 North State Street
 Jackson, Mississippi 39201

CODED

WATER WELL DRILLERS LOG

1-6 1970 Penton Well Serv Pearl River
 date well completed firm name county well located

LANDOWNER: Edward Spence
 Rt. 2 Box 223
 Carriere Miss
 (mailing address)

WELL LOCATION:
 sec. 1 T 5 N R 16 E
 S W
 3 miles North of Coasar
 (distance) (direction) (nearest town)

WELL PURPOSE: Home
 (home, irrigation, municipal, industrial)

WELL COMPLETION DATA: 5' Drilled

- (1) diameter (inches) 2"
- (2) total depth (feet) 313
- (3) static water level (feet) 73 below top of ground.
- (4) casing Galv 308 (material) (depth)
 2" (size) if telescope see back.
- (5) screen 5' 308 (length) (depth to top)
 2" S. Steel (size) (material)
- (6) pump 1 9 (HP) (yield gpm)
 Elec (type power)
- (7) electric log NO (yes or no)
- (organization running log)
- (8) how well bottom plugged B.W. Valva

description of formations encountered	from	to
Surface clay	0	22
Red sand	22	63
White clay	63	80
Blue clay	80	140
Mud	140	160
Blue clay	160	230
Fine sand	230	265
Blue clay	265	268
Grey sand	268	313


DRILLERS REMARKS:

FEB 11 1970

MISS. BD. OF WATER CONTROL

If well telescopes please sketch and show depths.

GROUND LEVEL

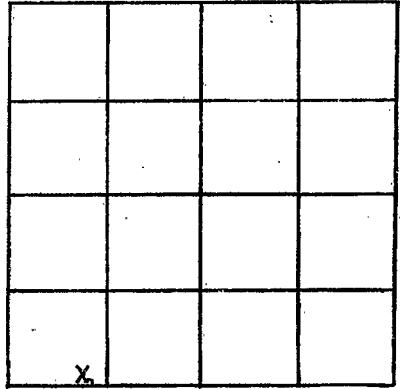

SECTION 1

Please indicate well location X.

ADDITIONAL INFORMATION

If more than one screen,
show locations of each on sketch.