

MISSISSIPPI
BOARD OF WATER COMMISSIONERS
416 North State Street
Jackson, Mississippi 39201

CODED

Pearl River
V 19
1-3-20

WATER WELL DRILLERS LOG


1-3-20 date well completed
E & J water well serv. firm name
Pearl River county well located

LANDOWNER:	description of formations encountered	from	to
Harvey Lumpkin Rt. 2 Carriere Miss. (mailing address)	Red surface 0 to 25 Fine white sand 25 55 Coarse Whit. sand & gravel 55 84		25 55 84
WELL LOCATION: sec. 12 T 5 N R 16 E 4 miles East of Carriere (distance) (direction) (nearest town)			
WELL PURPOSE: Home (home, irrigation, municipal, industrial)			
WELL COMPLETION DATA: (1) diameter (inches) 4.5 (2) total depth (feet) 84 (3) static water level (feet) 42 below top of ground. (4) casing 2" O.D. 79 (material) (depth) If telescope see back. (5) screen 5' 79 (length) (depth to top) 2" 5.5 (size) (material) (6) pump 1/2 250 G.P.M. (HP) (yield gpm) Elect (type power) (7) electric log NO (yes or no) (organization running log)			
(8) how well bottom plugged Shoe			
DRILLERS REMARKS:			

FEB 26 1970
MISS. BR. OF WATER COM.

If well telescopes please sketch and show depths.

GROUND LEVEL

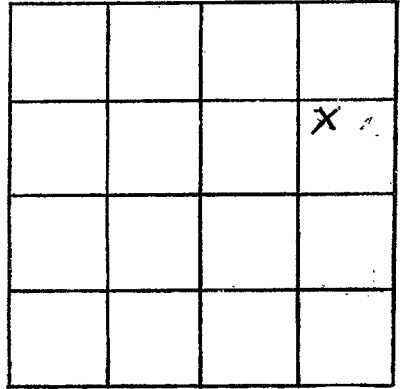

SECTION 12

Please indicate well location X.

ADDITIONAL INFORMATION

If more than one screen,
show locations of each on sketch.