

Pearl River
 V 21
 3-18-70

MISSISSIPPI
 BOARD OF WATER COMMISSIONERS
 416 North State Street
 Jackson, Mississippi 39201

WATER WELL DRILLERS LOG

NEEL LUMPKIN WELL DRILLING SERVICE
 P. O. BOX 117
 CARROLL, MISS.

3-18 1970
 date well completed

from name

county well located

COPIED
 Pearl River

LANDOWNER: W. A. Taylor
4700 Mark Twain
New Orleans, La.
 (mailing address)

description of formations encountered	from	to
Surface Clay	0	10
✓ sand	10	60

WELL LOCATION:
 sec. 35 T 5 R 16
6 miles East of Carroll
 (distance) (direction) (nearest town)

red clay + sand streaks	60	120
blue clay	120	200

WELL PURPOSE: home
 (home, irrigation, municipal, industrial)

good sand, fine to better	200	238
---------------------------	-----	-----

- WELL COMPLETION DATA:
- (1) diameter (inches) 123 - 4"
 - (2) total depth (feet) 238
 - (3) static water level (feet) 61 below top of ground.
 - (4) casing galv. (material) (depth)
 - see D if telescope see back. (size)
 - (5) screen 10' (length) (depth to top)
 - 2" (size) St. Steel (material)
 - (6) pump 1 (HP) (yield gpm)
 - electric (type power)
 - (7) electric log no. (yes or no)

COPIED

(organization running log)

APR 13 1970


(8) how well bottom plugged Johnson back pressure valve

MISS. BD. OF WATER COMMISSIONERS

DRILLERS REMARKS:

If well telescopes please sketch and show depths.

GROUND LEVEL

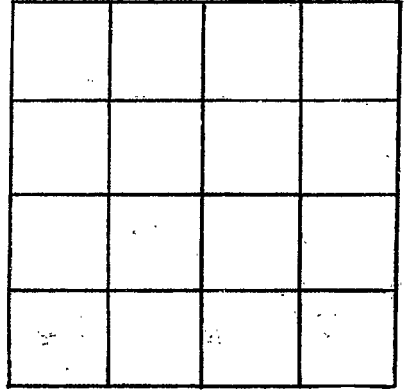

SECTION _____

Please indicate well location X.

ADDITIONAL INFORMATION

If more than one screen, show locations of each on sketch.