

Pearl River  
 V 22  
 3-25-70

MISSISSIPPI  
 BOARD OF WATER COMMISSIONERS  
 416 North State Street  
 Jackson, Mississippi 39201

WATER WELL DRILLERS LOG  
 NEIL LUMPKIN WELL DRILLING SERVICE

P. O. BOX 117  
 CARRIERE, MISS.  
 firm name

CODED  
 Pearl River

3-25 1970  
 date well completed

county well located

LANDOWNER:  
 Ronald A. Olson  
 3112 Rabbits Street  
 Carriere, N.D., La.  
 (mailing address)

description of formations encountered	from	to
Hard brown clay	0	25
Surface sand, no good	25	45
Blue clay, slow drilling	45	300
Fine to better sand	300	363

WELL LOCATION:  
 sec. 5 T. 5 R. 15  
 Lake #4 miles East of Carriere  
 (distance) (direction) (nearest town)

WELL PURPOSE: Home  
 (home, irrigation, municipal, industrial)

- WELL COMPLETION DATA:
- diameter (inches) 2"
  - total depth (feet) 363
  - static water level (feet) 53 below top of ground.
  - casing galv. (material) (depth)  
2" (size) If telescope see back.
  - screen 5' (length) (depth to top)  
2" (size) St. Steel (material)
  - pump 1 (HP) 600 gpm. (yield gpm)  
electric (type power)
  - electric log no (yes or no)

CODED

(organization running log)

APR 13 1970


(8) how well bottom plugged Johnson  
B.P. Valade

MISS. BD. OF  
 WATER COMM.

DRILLERS REMARKS:

If well telescopes please sketch and show depths.

GROUND LEVEL

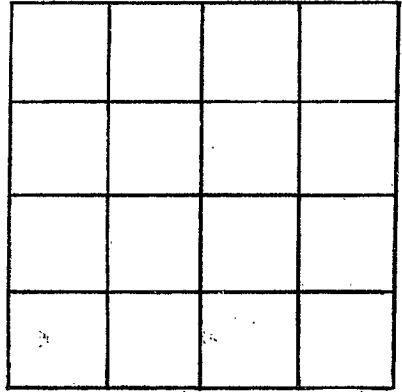

SECTION \_\_\_\_\_

Please indicate well location X.

ADDITIONAL INFORMATION

If more than one screen, show locations of each on sketch.