

PEARL RIVER
V 24
4-8-71

MISSISSIPPI
 BOARD OF WATER COMMISSIONERS
 416 North State Street
 Jackson, Mississippi 39201

CODED

WATER WELL DRILLERS LOG

4-8 19**71** **PONTON Well Serv** **Pearl River**
 date well completed firm name county well located

LANDOWNER: Jerry Kukowsky
RT 3 Box 189A
Picayune MISS
 (mailing address)

description of formations encountered	from	to
Surface clay	0	16
Red Sand	16	65
White Clay	65	83
Blue Clay	83	360
Sand	360	431

WELL LOCATION:
 sec. 23 T. 5 S. R. 16 W.
1 miles NW of Caesar
 (distance) (direction) (nearest town)

WELL PURPOSE: Home
 (home, irrigation, municipal, industrial)

WELL COMPLETION DATA:

- (1) diameter (inches) 2
- (2) total depth (feet) 431
- (3) static water level (feet) 72 below top of ground.
- (4) casing Galv, 421,
 (material) (depth)
2 If telescope see back.
 (size)
- (5) screen 10, 421
 (length) (depth to top)
2, S. Steel
 (size) (material)
- (6) pump 1, 9
 (HP) (yield gpm)
Elec
 (type power)
- (7) electric log NO
 (yes or no)

CODED

(organization running log)

MAY 3 - 1971


(8) how well bottom plugged B.W. Valve

MISS. RD. OF
 WATER COMM.

DRILLERS REMARKS:

If well telescopes please sketch and show depths.

GROUND LEVEL

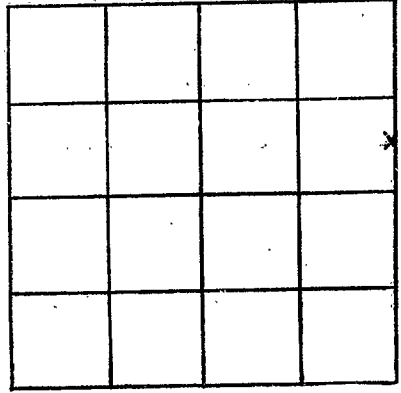

SECTION 23

Please indicate well location X.

ADDITIONAL INFORMATION

If more than one screen, show locations of each on sketch.