

PEARL RIVER
 V 25
 3-23-71

MISSISSIPPI
 BOARD OF WATER COMMISSIONERS
 416 North State Street
 Jackson, Mississippi 39201

CODED

WATER WELL DRILLERS LOG

3/23/1971 NEIL LUMPKIN WELL DRILLING SERVICE Pearl River
 P. O. BOX 117
 GARDNER, MISS. county well located

LANDOWNER: Don Melah
Carriere, Miss.
Route 2
 (mailing address)

description of formations encountered	from	to
Surface clay	0	10
sand	10	60
Blue clay & shale	60	360
Good grey sand	360	426

WELL LOCATION:
 sec. 13 T-5 S R-16 W
2 miles N of Carriere
 (distance) (direction) (nearest town)

WELL PURPOSE: home
 (home, irrigation, municipal, industrial)

- WELL COMPLETION DATA:
- (1) diameter (inches) 2"
 - (2) total depth (feet) 426'
 - (3) static water level (feet) 75 below above top of ground.
 - (4) casing galv. (material) (depth) 2" (size) If telescope see back.
 - (5) screen 5' (length) (depth to top) 2" (size) Stainless Steel (material)
 - (6) pump 1 (HP) 600 gpm. (yield/gpm) electric (type power)
 - (7) electric log no! (yes or no)
- (organization running log)

CODED

(8) how well bottom plugged Johnson
Back pressure valve


DRILLERS REMARKS:

MAY 4 1971

MISS. Bd. OF
 WATER COMMISSIONERS

If well telescopes please sketch and show depths.

GROUND LEVEL

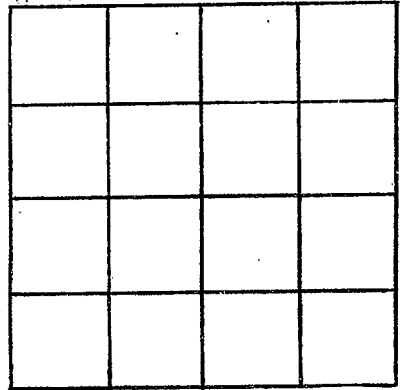

SECTION _____

Please indicate well location X.

ADDITIONAL INFORMATION

If more than one screen, show locations of each on sketch.