

PEARL RIVER
 V26
 4-29-71

MISSISSIPPI
 BOARD OF WATER COMMISSIONERS
 416 North State Street
 Jackson, Mississippi 39201

CODED

WATER WELL DRILLERS LOG

4-29 1971 Leaton Well Serv Pearl River
 date well completed firm name county well located

LANDOWNER: L.R. Barnum
Rt. 2 Box 182
Picayune Miss.
 (mailing address)

description of formations encountered	from	to
	Surface clay	0
Red sand	18	98
White clay	98	105
Blue clay	105	200
Sand	200	229

WELL LOCATION:
 sec. 36 T. 5 S. R. 16 W.
1 1/2 miles South of Caesar
 (distance) (direction) (nearest town)

WELL PURPOSE: Home
 (home, irrigation, municipal, industrial)

- WELL COMPLETION DATA:
- (1) diameter (inches) 2
 - (2) total depth (feet) 229
 - (3) static water level (feet) 69 below top of ground.
 - (4) casing Galv, 224,
 (material) (depth)
2 If telescope see back.
 (size)
 - (5) screen 5, 224
 (length) (depth to top)
2, S. Steel
 (size) (material)
 - (6) pump 1 9
 (HP) (yield gpm)
Elec
 (type power)
 - (7) electric log No
 (yes or no)
 (organization running log)
 - (8) how well bottom plugged Blw Valve


CODED

MAY 13 1971

DRILLERS REMARKS:

If well telescopes please sketch and show depths.

GROUND LEVEL

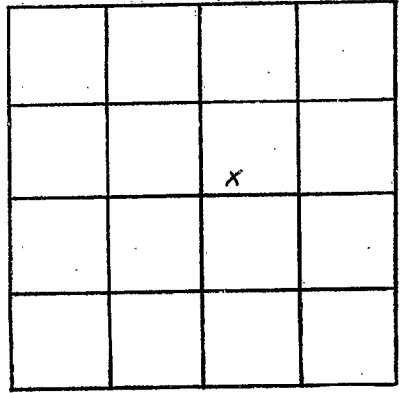

SECTION 36

Please indicate well location X.

ADDITIONAL INFORMATION

If more than one screen, show locations of each on sketch.