

PEARL RIVER
V 29
5-25-71

MISSISSIPPI
BOARD OF WATER COMMISSIONERS
416 North State Street
Jackson, Mississippi 39201

CODED

WATER WELL DRILLERS LOG

5-25-71
date well completed

1971 NEIL LUMPKIN WELL DRILLING SERVICE Pearl River
firm name BOX 117
CARRIERE, MISS. county well located

LANDOWNER: Chas. Rayford Burg

description of formations encountered

from to

Carrriere, Miss.
Route
(mailing address)

Surface clay
 sand

0 7
7 47

WELL LOCATION:

sec. 34 T 5 N R 16 E
S
6 1/4 miles SE of McDull
(distance) (direction) (nearest town)

Blue clay

47 180

Fine sand

180 230

WELL PURPOSE: Home
(home, irrigation, municipal, industrial)

Blue shale

230 260

WELL COMPLETION DATA:

- (1) diameter (inches) 2"
- (2) total depth (feet) 741
- (3) static water level (feet) _____ below above top of ground.

Good sand but

260 365

Contains marine

bacteria

Blue clay & shale

365 690

Fine to better sand

690 741

- (4) casing galv. (material), _____ (depth)
2" (size) if telescope see back.

- (5) screen 5' (length), _____ (depth to top)
2" (size), Stainless Steel (material)

- (6) pump 1 (HP), 350 gph (yield gpm)
electric (type power)

- (7) electric log No. (yes or no)

CODED

(organization running log)


- (8) how well bottom plugged Johnson
B.P. Valve

DRILLERS REMARKS:

MISS. BD. OF
WATER COMM.

If well telescopes please sketch and show depths.

GROUND LEVEL

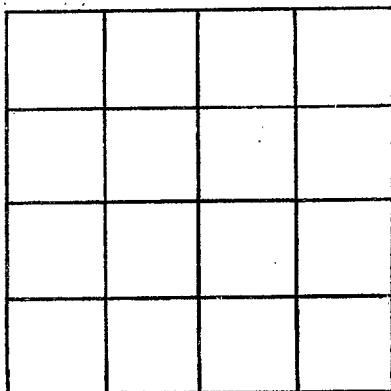

SECTION _____

Please indicate well location X.

ADDITIONAL INFORMATION

If more than one screen,
show locations of each on sketch.