

V-31
11-8-60

WATER WELL DRILLERS LOG

OK-301

Date: 11-8, 1960, Driller: Jack & Eric P.R.
311-5 (Name)

CODED

(1) Owner of Land: Clifford Lee

(Name)

Lee Farms Miss.

(Address)

(2) Location: 1/4, 1/4, Sec. 13 T5 R16,

8 miles east of Peapack
(distance) (direction) (Nearest Town)

(3) Topography: X
(Hilly) (Flat) (Level)

(4) Purpose of Well:
(Domestic Irrigation
Municipal, Industrial, Other)

Description & Color of Materials
Sand, Clay, Red Clay, Shell, etc.

Thick-
ness
Feet

Depth
Feet

Surface Sand - 0 70
Blue clay 70 370
gravel sand 370 405

Information upon completion of well:

(1) Diameter 2 inches.

(2) Total Depth 65 feet.

(3) Water Level 405 feet below top of ground.

(4) Cased to _____, Size _____

(5) Screen: Size 2", Length 5'

(6) Were any formations sealed against pollution?

yes, X no.


If YES depth of formation _____

Why _____

Drillers Remarks: good Pump

well water level
6.5'

~~CODED~~

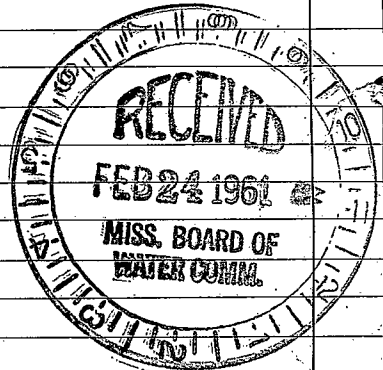

(Use Back Side)

Well No.

