

P.R.
V 32
6/24/74

MISSISSIPPI
BOARD OF WATER COMMISSIONERS CODED
416 North State Street
Jackson, Mississippi 39201

WATER WELL DRILLERS LOG

6-24 74 Bud Kerton & Son Pearl River
date well completed firm name county well located

LANDOWNER:
H. N. Wilderman
Dearyne Miss.
(mailing address)

description of formations encountered	from	to
White Shale	0	32
Blue Shale	32	555
Grey Sand & Rock	555	587

WELL LOCATION:
sec. 12 T. 5 N R. 16 E
4 miles NE of Dearyne
(distance) (direction) (nearest town)

WELL PURPOSE: Home
(home, irrigation, municipal, industrial)


WELL COMPLETION DATA:
(1) diameter (inches) 4 x 2
(2) total depth (feet) 587
(3) static water level (feet) 33 below top of ground.
(4) casing Galv. 577 (material) (depth)
(size) if telescope see back.
(5) screen 2x10 577 (length) (depth to top)
2x10 Stainless Steel (size) (material)
(6) pump 3/4 900 (HP) (yield gpm)
electric (type power)
(7) electric log (yes or no)

CODED

(organization running log)

(8) how well bottom plugged
Sand Shale

DRILLERS REMARKS:

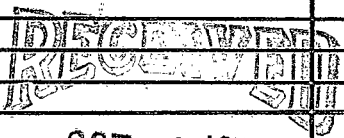

OCT - 9 1974

MISS. BD. OF WATER COMMISSIONERS

