

Pearl R.
V-33

WATER WELL DRILLERS LOG

Date: 12-1, 1961, Driller: J Beck

County: Pearl River

12-1-61

(Name)

CODED

(1) Owner of Land: Iron Palmers
Rt 2 Piccadune, Miss
(Name)
(Address)

(2) Location: 1/4, 1/4, Sec. 36 T5R16
2 1/2 miles North, of Canton, Miss.
(distance) (direction) (Nearest Town)

(3) Topography: (Hilly) (Flat) (Level)

(4) Purpose of Well:
(Domestic Irrigation
Municipal, Industrial, Other)

Description & Color of Material Sand, Clay, Red Clay, Shell, etc.	Feet	Depth Feet
Red sand + mud	40	40
Gravel	20	60
White sand	20	120
Blue mud	80	200
Hard Blue mud	36	236
Stratia	15	251


Information upon completion of well:

- (1) Diameter: 2" x 1/4" inches.
- (2) Total Depth: 251 feet.
- (3) Water Level: flows feet below top of ground.
- (4) Cased to _____, Size _____.
- (5) Screen: Size 1/4", Length 10 ft.
- (6) Were any formations sealed against pollution?
_____ yes, _____ no.

If YES depth of formation _____

Why _____

Drillers Remarks: _____

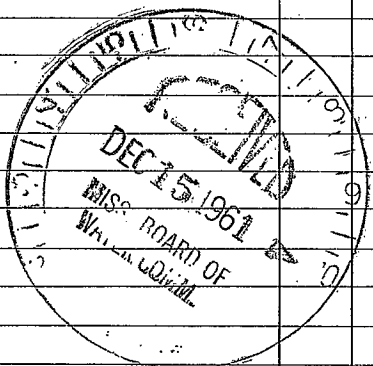

(Use Back Side)

Well No.

Retain this copy for your office files.

