

Pearl R.  
V-34

# WATER WELL DRILLERS LOG

Date: 12-8, 1961, Driller: J. Best  
12-8-61 325-16

(Name)

County: Pearl River

**CODED**

(1) Owner of Land: Luther Johnson  
(Name)  
Rt 2 Queyrene  
(Address)

(2) Location: 1/4, 1/4, Sec. 23 T5 R16,  
1 1/2 miles North of Cass  
(distance) (direction) (Nearest Town)

(3) Topography:  (Hilly)  (Flat)  (Level)

(4) Purpose of Well: Home  
(Domestic Irrigation  
Municipal, Industrial, Other)

Description & Color of Material Sand, Clay, Red Clay, Shell, etc.	Thickness Feet	Depth Feet
Red Clay	25	25
White sand	80	105
Hard Blue mud	10	215
Fine sand	20	235
Coarse strata	34	309
		309

### Information upon completion of well:

(1) Diameter: 2" x 1 1/2" inches.

(2) Total Depth: 309 feet.

(3) Water Level: 70 feet below top of ground.

(4) Cased to \_\_\_\_\_, Size \_\_\_\_\_

(5) Screen: Size 1 1/4", Length 15 ft.


(6) Were any formations sealed against pollution?  
\_\_\_\_\_ yes, \_\_\_\_\_ no.

If YES depth of formation \_\_\_\_\_

Why \_\_\_\_\_

Drillers Remarks: \_\_\_\_\_

**CODED**

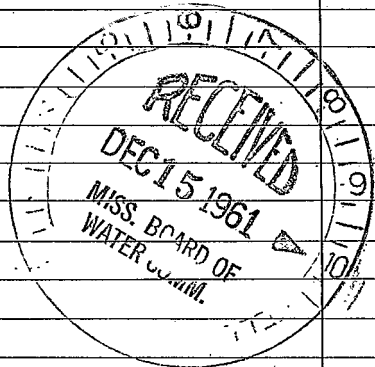

Well No.:

(Use Back Side)

Retain this copy for your office files.

