

WV-35

12-18-61

WATER WELL DRILLERS LOG

CODED

Date: Dec. 18, 1962, Driller: M&B Drilling Co. County Pearl River
(Name)

(1) Owner of Land: G.W. Harbeson
(Name)
Carrier, Miss.
(Address)

(2) Location: 1/4, 1/4, Sec. 18 T5R16
East Side of Railroad - Center
Carrier
(distance), (direction), (Nearest Town)
1/4 miles, of Carrier

(3) Topography: Hilly
(Hilly) (Flat) (Level)

(4) Purpose of Well: Domestic
(Domestic Irrigation, Municipal, Industrial, Other)

Description & Color of Materials Sand, Clay, Red Clay, Shell, etc.	Thick- ness Feet	Depth Feet
Red Clay	73	13
White Sand	42	55
" " & Gravel	13	68
Red & White Clay & Gravel	40	108
Blue Clay, Soft	160	268
Hard Pink & Blue Clay	167	435
Sand & Clay Braks	7	442
Hard Blue Clay	33	475
Fine Grey Sand	30	505
Coarse Grey Sand	50	555

Information upon completion of well:

(1) Diameter 2 inches.

(2) Total Depth 535 feet.

(3) Water Level 70 feet below top of ground.


(4) Cased to 525, Size 2"

(5) Screen: Size 8 1/4" x 2", Length 10 FT.

(6) Were any formations sealed against pollution?
 yes, no.

Still cutting sand when pair cutting hole

CODED

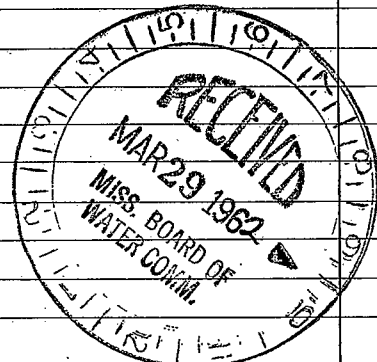

(Use Back Side)

Well No.

[The page contains extremely faint and illegible text, likely bleed-through from the reverse side of the document. The text is scattered across the page and does not form any recognizable words or sentences.]