

Pearl River  
 V 38  
 4-29-70

MISSISSIPPI  
 BOARD OF WATER COMMISSIONERS  
 416 North State Street  
 Jackson, Mississippi 39201

WATER WELL DRILLERS LOG

4-29-70 date well completed 19 70 Ponton Well Serv Pearl River firm name county well located

LANDOWNER: Truman Hambrice  
 Rt. 3 Box 156A  
 Picayune Miss  
 (mailing address)

description of formations encountered	from	to
Surface clay	0	26
Red sand	26	105
White clay	105	115
Blue clay	115	180
Fine sand	180	212
Blue clay	212	390
Grey sand	390	430

WELL LOCATION:  
 sec. 36 T 5 S R 16 W  
 0 miles south of Caesar  
 (distance) (direction) (nearest town)

WELL PURPOSE: Home  
 (home, irrigation, municipal, industrial)


- WELL COMPLETION DATA:
- (1) diameter (inches) 2
  - (2) total depth (feet) 430
  - (3) static water level (feet) 55 below ~~above~~ top of ground.
  - (4) casing Galv, 420, (material) (depth)  
 2 (size) if telescope see back.
  - (5) screen 10', 430 (length) (depth to top)  
 2, S. Steel (size) (material)
  - (6) pump 1 (HP) 10 (yield gpm)  
 Elec (type power)
  - (7) electric log NO (yes or no)
  - (organization running log)
  - (8) how well bottom plugged B.V. Valve

DRILLERS REMARKS:

MAY 5 1970

If well telescopes please sketch and show depths.

GROUND LEVEL

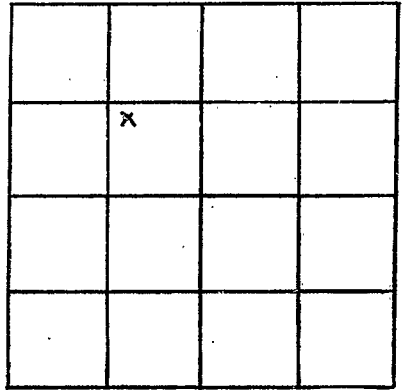

SECTION 36

Please indicate well location X.

ADDITIONAL INFORMATION

If more than one screen,  
show locations of each on sketch.