

Pearl River  
V 41  
7-29-70

MISSISSIPPI  
BOARD OF WATER COMMISSIONERS  
416 North State Street  
Jackson, Mississippi 39201

**CODED**

WATER WELL DRILLERS LOG

7-29 1970 Neil Benjamin Pearl River  
date well completed firm name county well located

LANDOWNER: Anchor Lake  
Carriere, Miss.  
Route 2  
(mailing address)

description of formations encountered	from	to
<u>Surface Clay</u>	<u>0</u>	<u>20</u>
<u>v sand, no good</u>	<u>20</u>	<u>30</u>
<u>Blue Clay</u>	<u>30</u>	<u>300</u>
<u>Fine to better sand</u>	<u>300</u>	<u>384</u>

WELL LOCATION:  
sec 5 T 5 N R 16 E  
4 miles EAST of CARRIER  
(distance) (direction) (nearest town)

WELL PURPOSE: sub-house  
(home, irrigation, municipal, industrial)

- WELL COMPLETION DATA:
- (1) diameter (inches) 2"
  - (2) total depth (feet) 384'
  - (3) static water level (feet) 20 below above-top of ground.
  - (4) casing galvs (material) (depth)  
2" if telescope see back. (size)
  - (5) screen 5' (length) (depth to top)  
2" (size) St. Steel (material)
  - (6) pump 3/4 (HP) 650gph (yield gpm)  
electric (type power)
  - (7) electric log no (yes or no)

**CODED**

(organization running log)

(8) how well bottom plugged Johnson  
at 374' depth


DRILLERS REMARKS:

SEP 22 1970

MISS. RD. OF  
WATER COMM

If well telescopes please sketch and show depths.

GROUND LEVEL

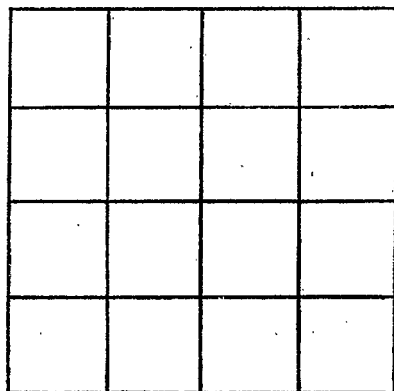

SECTION \_\_\_\_\_

Please indicate well location X.

ADDITIONAL INFORMATION

If more than one screen, show locations of each on sketch.