

Pearl River
V42
7-29-70

MISSISSIPPI
BOARD OF WATER COMMISSIONERS
416 North State Street
Jackson, Mississippi 39201

CODED

WATER WELL DRILLERS LOG

7-29 1970 Neil Lumpkin Pearl River
date well completed firm name county well located

LANDOWNER: John Hill
Carriere, Rt. 23

description of formations encountered	from	to
Surface Clay	0	20
Good v sand	20	80
Blue Clay	80	180
Good sand	180	237

(mailing address)

WELL LOCATION:

sec 35 T 5 R 16 E
6 miles SE of Carriere
(distance) (direction) (nearest town)

WELL PURPOSE: home
(home, irrigation, municipal, industrial)

WELL COMPLETION DATA:

- (1) diameter (inches) 2"
- (2) total depth (feet) 237'
- (3) static water level (feet) 70 below top of ground.
- (4) casing galv. (material) (depth)
2" (size) if telescope see back.
- (5) screen 5' (length) (depth to top)
2" (size) St. Steel (material)
- (6) pump 1 (HP) 650 gpm. (yield gpm)
- electric (type power)
- (7) electric log no. (yes or no)

(organization running log)

(8) how well bottom plugged Johnson BT Valve


DRILLERS REMARKS:

CODED

SEP 22 1970

If well telescopes please sketch and show depths.

GROUND LEVEL

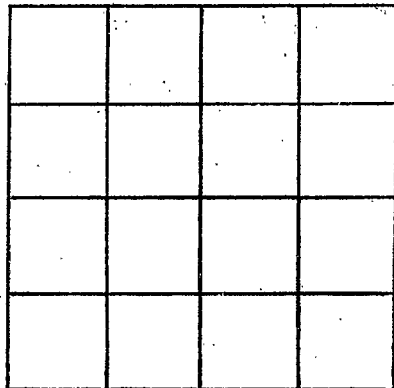

SECTION _____

Please indicate well location X.

ADDITIONAL INFORMATION

If more than one screen, show locations of each on sketch.