

PEARL RIVER
 V 47
 9-25-70

MISSISSIPPI
 BOARD OF WATER COMMISSIONERS
 416 North State Street
 Jackson, Mississippi 39201

CODED

WATER WELL DRILLERS LOG

9-25 1970 E. J. Water wells, Pearl River
 date well completed firm name county well located

LANDOWNER:
Coleman Harvey
Corriere Miss.
 (mailing address)

description of formations encountered	from	to
<u>Red clay</u>	<u>0</u>	<u>32</u>
<u>Red co. sd. gravel</u>	<u>32</u>	<u>125</u>

WELL LOCATION:
~~4~~ 5 T 5 N R 16 E
~~SE~~ SW W
2 miles East of Corriere
 (distance) (direction) (nearest town)

<u>Red clay</u>	<u>125</u>	<u>198</u>
<u>med gr sd.</u>	<u>198</u>	<u>222</u>

WELL PURPOSE: Home
 (home, irrigation, municipal, industrial)

WELL COMPLETION DATA:

(1) diameter (inches) 4 5/8

(2) total depth (feet) 223'

(3) static water level (feet) 81' below top of ground.

(4) casing Galv., 217'
 (material) (depth)
2"
 (size) if telescope see back.

(5) screen 5', 217-222'
 (length) (depth to top)
2", 5 S
 (size) (material)

(6) pump 1, 360
 (HP) (yield gpm)
Elect
 (type power)

(7) electric log NO
 (yes or no)

(organization running log)

(8) how well bottom plugged Shoe

CODED


OCT 13 1970

MISS. BD. OF
 WATER COM.

DRILLERS REMARKS:

If well telescopes please sketch and show depths.

GROUND LEVEL

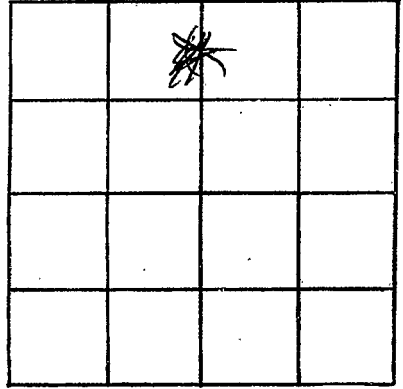

SECTION 4

Please indicate well location X.

ADDITIONAL INFORMATION

If more than one screen,
show locations of each on sketch.