

PEARL RIVER

149

10-23-70

MISSISSIPPI BOARD OF WATER COMMISSIONERS 416 North State Street Jackson, Mississippi 39201

CODED

WATER WELL DRILLERS LOG

10-23

1970 Ponton Well Serv

Pearl River

date well completed

firm name

county well located

LANDOWNER: Durwin Spence

Rt. 2 Box 254 A

Carriere MISS (mailing address)

WELL LOCATION:

sec. 24 T. 5 S. R. 16 E. W.

0 miles North of Caesar (distance) (direction) (nearest town)

WELL PURPOSE: HOME (home, irrigation, municipal, industrial)

WELL COMPLETION DATA: 4 1/2

- (1) diameter (inches) 2
(2) total depth (feet) 433
(3) static water level (feet) 80 below top of ground.

- (4) casing Galv (material), 433 (depth)
2 (size) if telescope see back.

- (5) screen 10 (length), 433 (depth to top)
2" (size), S. Steel (material)

- (6) pump 1 (HP), 8 (yield gpm)
Elec (type power)

- (7) electric log NO (yes or no)
(organization running log)

- (8) how well bottom plugged B.W. Valve

description of formations encountered

from

to

Table with 3 columns: description of formations encountered, from, to. Rows include Surface Clay (0-18), Red Sand (18-85), White Clay (85-95), Blue Clay (95-180), mud (180-192), Blue Clay (192-400), Grey Sand (400-433).

CODED


NOV 24 1970

DRILLERS REMARKS:

MISS. BD. OF WATER COMM.

If well telescopes please sketch and show depths.

GROUND LEVEL

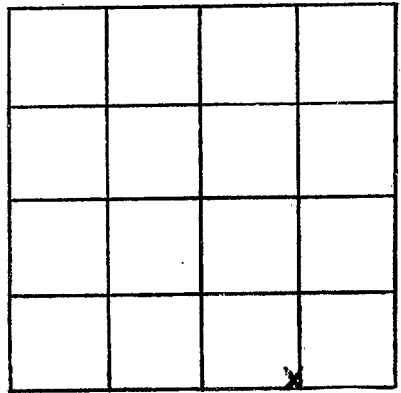

SECTION 24

Please indicate well location X.

ADDITIONAL INFORMATION

If more than one screen, show locations of each on sketch.