

PEARL RIVER
V 51
9-29-70

MISSISSIPPI
BOARD OF WATER COMMISSIONERS
416 North State Street
Jackson, Mississippi 39201

CODED

WATER WELL DRILLERS LOG

9-29-70 date well completed 1970 firm name Pearl River county well located

LANDOWNER:
Mr. C. B. Ponce
Rt. 2 Box 732 Corriere
(mailing address) MISS.

description of formations encountered	from	to
Red clay	0	14
white gravel		
Red clay	14	66
fine white sand	66	80
coarse white sand	80	96

WELL LOCATION:
sec. 13 T 2 N R 16 E
5 miles East Corriere
(distance) (direction) (nearest town)

WELL PURPOSE: Home
(home, irrigation, municipal, industrial)

WELL COMPLETION DATA:

(1) diameter (inches) 7 1/2"

(2) total depth (feet) 96

(3) static water level (feet) 50 below top of ground.

(4) casing Plastic, 86'
(material) (depth)
4" if telescope see back.
(size)

(5) screen 10, 86-96
(length) (depth to top)
4" Plastic
(size) (material)

(6) pump 1/2 735 gpm
(HP) (yield gpm)
Elect Sub.
(type power)

(7) electric log NO
(yes or no)

(organization running log)

(8) how well bottom plugged shoe

CODED


JAN 26 1971

DRILLERS REMARKS:

MISSISSIPPI BOARD OF WATER COMMISSIONERS

If well telescopes please sketch and show depths.

GROUND LEVEL

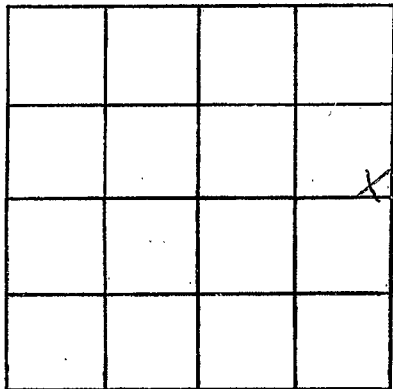

SECTION 13

Please indicate well location X.

ADDITIONAL INFORMATION

If more than one screen, show locations of each on sketch.