

PEARL RIVER
 V 56
 1-19-71

MISSISSIPPI
 BOARD OF WATER COMMISSIONERS
 416 North State Street
 Jackson, Mississippi 39201

CODED

WATER WELL DRILLERS LOG

1-19 date well completed 1971 Penton Well Serv firm name Pearl River county well located

LANDOWNER: Lynwood Davis
Rt. 3 Box 133
Picayune Miss
 (mailing address)

description of formations encountered	from	to
Surface Clay	0	18
Sand	18	63
White clay	63	75
Blue clay	75	192
Fine sand	192	212
Blue clay	212	538
Sand	538	577

WELL LOCATION:
 sec. 35 T. 5 S. R. 16 W.
5 miles N.E. of Picayune
 (distance) (direction) (nearest town)

WELL PURPOSE: Home
 (home, irrigation, municipal, industrial)

- WELL COMPLETION DATA:
- (1) diameter (inches) 2
 - (2) total depth (feet) 577
 - (3) static water level (feet) 43 below top of ground.
 - (4) casing Galv 557
 (material) (depth)
2 If telescope see back.
 (size)
 - (5) screen 10 557
 (length) (depth to top)
2 S. Steel
 (size) (material)
 - (6) pump 1 11
 (HP) (yield gpm)
Elec
 (type power)
 - (7) electric log NO
 (yes or no)
 - (organization running log)
 - (8) how well bottom plugged B.W. Valve

CODED


FEB 1 1971

DRILLERS REMARKS:

MISS. BD. OF
 WATER COMMISSIONERS

If well telescopes please sketch and show depths.

GROUND LEVEL

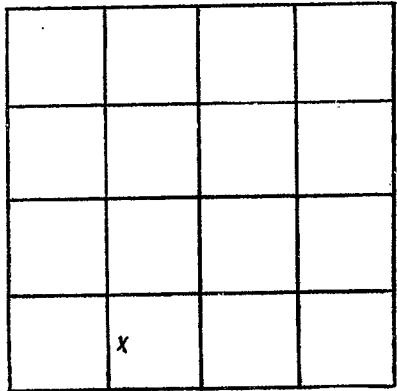

SECTION 35

Please indicate well location X.

ADDITIONAL INFORMATION

If more than one screen, show locations of each on sketch.