

PEARL RIVER
V 57
1-13-71

MISSISSIPPI
BOARD OF WATER COMMISSIONERS
416 North State Street
Jackson, Mississippi 39201

CODED

WATER WELL DRILLERS LOG

NEIL LUMPKIN WELL DRILLING SERVICE

P. O. BOX 117
CARRIERS, MISS.
firm name

Pearl River
county well located

1-13-1971
date well completed

LANDOWNER: *Calvin Miller*
7225 Sally St.
Arabi, La. 70043
(mailing address)

description of formations
encountered

from to

WELL LOCATION:
sec. 8 T 5 R 16
3 miles East of Carrere
(distance) (direction) (nearest town)

<i>Surface Clay</i>	<i>0</i>	<i>10</i>
<i>v sand</i>	<i>10</i>	<i>60</i>
<i>Blue clay and some fine sand</i>	<i>60</i>	<i>300</i>
<i>Good sand</i>	<i>300</i>	<i>373</i>

WELL PURPOSE:
(home, irrigation, municipal, industrial)

WELL COMPLETION DATA:

- diameter (inches) 2"
- total depth (feet) 373'
- static water level (feet) 90 below top of ground.
- casing galv. (material), (depth)
2" if telescope see back.
(size)
- screen 5' (length), (depth to top)
2" (size), Stainless Steel (material)
- pump 1 (HP), (yield gpm)
electric (type power)
- electric log No (yes or no)

CODED

(organization running log)

MAR 10 1971


(8) how well bottom plugged Johnson
Back Pressure Valve

MISS. BD. OF
WATER COMM.

DRILLERS REMARKS:

If well telescopes please sketch and show depths.

GROUND LEVEL

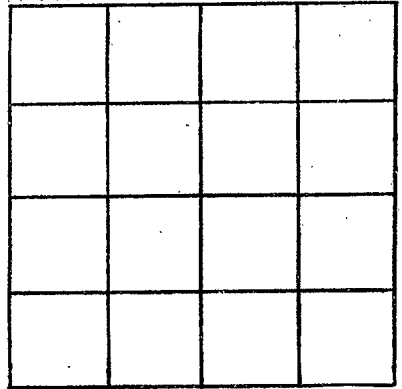

SECTION _____

Please indicate well location X.

ADDITIONAL INFORMATION

If more than one screen, show locations of each on sketch.