

Pearl R.
V-59

WATER WELL DRILLERS LOG

CODED PEARL
County RIVER

Date: SEPT 18 1963, Driller: POUPART
9-18-63 301-36 (Name)

(1) Owner of Land: ALBERT PALMER
(Name)
RT. CARRIERE MISS
(Address)

Description & Color of Materials Sand, Clay, Red Clay, Shell, etc.	Thick- ness Feet	Depth Feet
<u>RED SAND</u>	<u>20</u>	
<u>SAND & GRAVEL</u>	<u>60</u>	<u>80</u>
<u>GREY CLAY</u>		
<u>4 Small SAND BREAKS</u>	<u>190</u>	<u>270</u>
<u>GREY SAND</u>	<u>22</u>	<u>292</u>

(2) Location: 1/4, 1/4, Sec. 8 T5 R6,
3 miles EAST, of CARRIERE
(distance) (direction) (Nearest Town)

(3) Topography:
(Hilly) (Flat) (Level)

(4) Purpose of Well: DOMESTIC
(Domestic Irrigation
Municipal, Industrial, Other)

Information upon completion of well:


- (1) Diameter 2 inches.
- (2) Total Depth 292 feet.
- (3) Water Level 125 feet below top of ground.
- (4) Cased to _____, Size _____
- (5) Screen: Size 010, Length 05'
- (6) Were there any formations sealed against pollution?
_____ yes, _____ no.

If YES depth of formation _____

Why _____

Drillers Remarks: _____

CODED

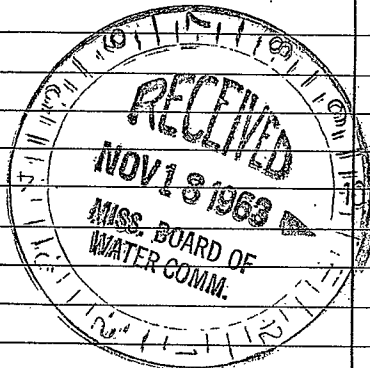

(Use Back Side)

Well No.

1870
1871
1872
2140