

Pearl R.

0V-63

2-8-66

MISSISSIPPI BOARD OF WATER COMMISSIONERS

WATER WELL DRILLERS LOG

CODED

Date: 2-8, 1966, Driller: Neil Lumpkin County (Name)

338-6

(1) Owner of Land: James Howard Kirk (Name) land Carriere Route 2 (Address)

| Description & Color of Materials<br>Sand, Clay, Red Clay, Shell, etc. | Thick-<br>ness<br>Feet | Depth<br>Feet |
|---|------------------------|---------------|
| Surface Clay  | 0                      | 10            |
| Sand-fine to better   | 10                     | 45            |

(2) Location: 1/4, 1/4, Sec 28 T5 R6, 5 miles west of Carriere (distance) (direction) (Nearest Town)

(3) Topography: Hilly (Hilly) (Flat) (Level)

(4) Purpose of Well: Domestic (Domestic Irrigation Municipal, Industrial, Other)

Information upon completion of well:

(1) Diameter 2 inches.

(2) Total Depth 45 feet.

(3) Water Level 18 feet below top of ground.

(4) Cased to, Size

(5) Screen: Size 2", Length 6'

(6) Were any formations sealed against pollution?


yes, no

If YES depth of formation

Why

Drillers Remarks:

CODED

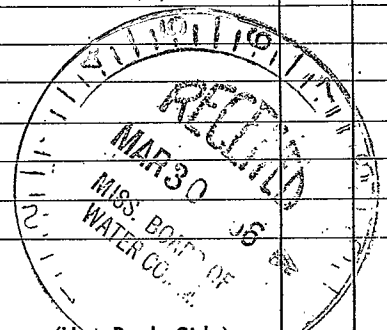

(Use Back Side)

Well No.

