

PEARL RIVER

V66

6-10-71

MISSISSIPPI  
 BOARD OF WATER COMMISSIONERS  
 416 North State Street  
 Jackson, Mississippi 39201

WATER WELL DRILLERS LOG

WELL DRILLING SERVICE

P. O. BOX 117

CARRIER, MISS

*Pearl River*  
**CODED**  
 county well located

6-10-1971  
date well completed

firm name

LANDOWNER *Dr. Geo. M. Haik*

description of formations encountered

from

to

*71 Audubon Blvd.*

*Surface Clay*

*0*

*10*

*New Orleans, La.*  
(mailing address)

*Sand*

*10*

*32*

WELL LOCATION:

sec. *33* T *5* R *16*

*Clay*

*32*

*480*

*3 3/4* miles *NE* of *Picayune*  
(distance) (direction) (nearest town)

*Fine to better sand*

*480*

*557*

WELL PURPOSE: *home*  
(home, irrigation, municipal, industrial)

WELL COMPLETION DATA:

- (1) diameter (inches) *2"*
- (2) total depth (feet) *557*
- (3) static water level (feet) *half flow below* above top of ground.

(4) casing *galv.*  
(material) (depth)

*2"*  
(size) if telescope see back.

(5) screen *5'*  
(length) (depth to top)

*2"* *St. Steel*  
(size) (material)

(6) pump *1/2* *550 gpm.*  
(HP) (yield gpm)

*electric*  
(type power)

(7) electric log *no*  
(yes or no)

(organization running log)

(8) how well bottom plugged *Johnson*  
*Back pressure valve*

DRILLERS REMARKS:


**CODED**

OCT 11 1971

MISS. DIV. OF  
WATER-SUPPLY

If well telescopes please sketch and show depths.

GROUND LEVEL

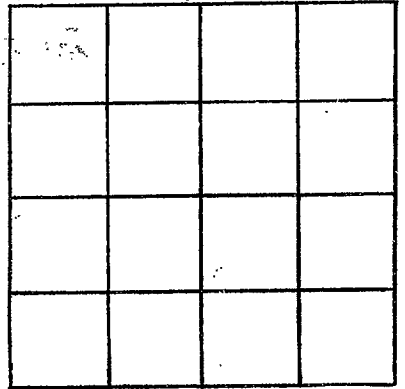

SECTION \_\_\_\_\_

Please indicate well location X.

ADDITIONAL INFORMATION

If more than one screen, show locations of each on sketch.