

Pearl River
V67
7-15-71

MISSISSIPPI
 BOARD OF WATER COMMISSIONERS
 416 North State Street
 Jackson, Mississippi 39201

WATER WELL DRILLERS LOG

CODED

Pearl River

date well completed 7-15-1971 firm name TIMPKIN WELL DRILLING SERVICE county well located CARRIAGE, MISS.

LANDOWNER: De Verle
"Hoot" Brannon
4716 Green Acres Ct.
Metairie, La.
 (mailing address)

description of formations encountered	from	to
<u>Surface Clay</u>	<u>0</u>	<u>10</u>
<u>✓ sand</u>	<u>10</u>	<u>40</u>
<u>Blue Clay</u>	<u>40</u>	<u>160</u>
<u>Good sand</u>	<u>160</u>	<u>206</u>

WELL LOCATION:
 sec. 8 T. 5 S. R. 16 W.
5 miles E of Carrriere
 (distance) (direction) (nearest town)

WELL PURPOSE: home
 (home, irrigation, municipal, industrial)

- WELL COMPLETION DATA:
- diameter (inches) 2"
 - total depth (feet) 206'
 - static water level (feet) _____ below above top of ground.
 - casing galv. (material), _____ (depth)
2" (size) if telescope see back.
 - screen 5' (length), _____ (depth to top)
2" (size), St. Steel (material)
 - pump _____ (HP) _____ (yield gpm)
 _____ (type power)
 - electric log No. (yes or no)
 _____ (organization running log)
 - how well bottom plugged _____

CODED


OCT 11 1971

DRILLERS REMARKS:
He furnished pump,
tanks, etc.

MISS. BD. OF
 WATER COMMISSIONERS

If well telescopes please sketch and show depths.

GROUND LEVEL

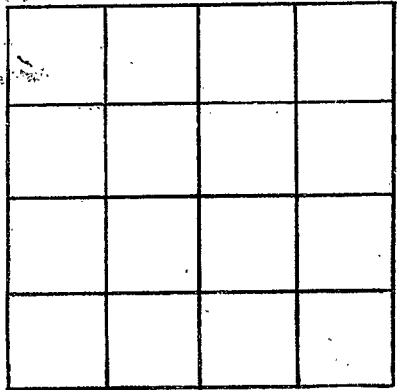

SECTION _____

Please indicate well location X.

ADDITIONAL INFORMATION

If more than one screen,
show locations of each on sketch.