

PEARL RIVER
V69
1-72

MISSISSIPPI
 BOARD OF WATER COMMISSIONERS
 416 North State Street
 Jackson, Mississippi 39201

CODED

WATER WELL DRILLERS LOG

19 72 Ponton Well Serv Pearl River
 date well completed firm name county well located

LANDOWNER: Ansel Smith
4674 Werner Dr.
New Orleans La
 (mailing address)

description of formations encountered	from	to
	Surface clay	0
Red sand	42	88
White clay	88	118
Blue clay	118	400
Sand	400	451

WELL LOCATION:
 sec. 23 T 5 S R. 16 W
2 miles N.W. of Caesar
 (distance) (direction) (nearest town)

WELL PURPOSE: Home
 (home, irrigation, municipal, industrial)

WELL COMPLETION DATA:

(1) diameter (inches) 2"

(2) total depth (feet) 451

(3) static water level (feet) 80 below top of ground.

(4) casing Galv. 431,
 (material) (depth)
2 if telescope see back.
 (size)

(5) screen 10 431
 (length) (depth to top)
2 St. Steel
 (size) (material)

(6) pump 1 6
 (HP) (yield gpm)
Elec
 (type power)

(7) electric log NO
 (yes or no)

(organization running log)

CODED

(8) how well bottom plugged B.W. Value


JAN 26 1972

DRILLERS REMARKS:

MISS. BD. OF
 WATER
 COMMISSIONERS

If well telescopes please sketch and show depths.

GROUND LEVEL

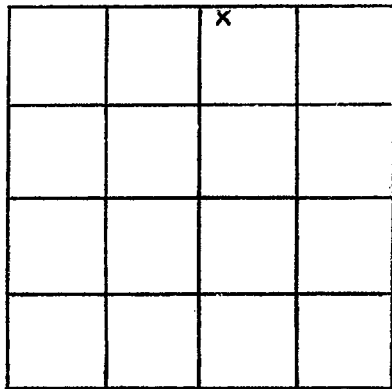

SECTION 23

Please indicate well location X.

ADDITIONAL INFORMATION

If more than one screen,
show locations of each on sketch.