

PEARL RIVER
 V76
 1-19-72

MISSISSIPPI
 BOARD OF WATER COMMISSIONERS
 416 North State Street
 Jackson, Mississippi 39201

CODED MAR 9 1972

WATER WELL DRILLERS LOG


1-19-72 date well completed
 72 Pearl River Well Pearl River
 Drilling Service firm name county well located

LANDOWNER: <u>C.A. Cross</u> <u>Picayune, Miss.</u> <u>Rt. 3, Box 159</u> (mailing address)	description of formations encountered	from	to
WELL LOCATION: sec <u>25</u> T <u>5</u> NE R <u>16</u> E <u>7</u> miles <u>W</u> of <u>Carmichael</u> (distance) (direction) (nearest town)	Surface clay	0	20
WELL PURPOSE: <u>home</u> (home, irrigation, municipal, industrial)	sand	20	80
WELL COMPLETION DATA: (1) diameter (inches) <u>2"</u>	Blue Clay	80	180
(2) total depth (feet) <u>216</u>	Good sand	180	216
(3) static water level (feet) <u>80</u> below above top of ground.			
(4) casing <u>galv</u> (material) (depth)			
<u>2"</u> if telescope see back. (size)			
(5) screen <u>5</u> (length) (depth to top)			
<u>S. Steel</u> (size) (material)			
(6) pump <u>3/4 (1/2) 250 gph.</u> (HP) (yield gpm)			
<u>electric pump</u> (type power)			
(7) electric log <u>no.</u> (yes or no)			
(organization running log)			
(8) how well bottom plugged <u>Johnson</u> <u>10 10 valve</u>			
DRILLERS REMARKS:			

CODED

If well telescopes please sketch and show depths.

GROUND LEVEL

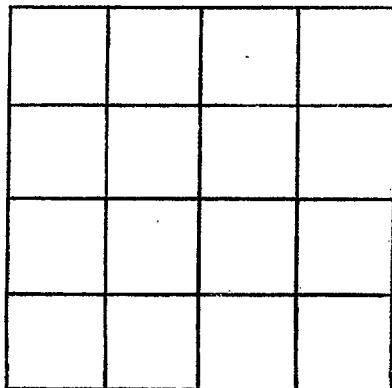

SECTION _____

Please indicate well location X.

ADDITIONAL INFORMATION

If more than one screen,
show locations of each on sketch.