

PEARL RIVER
V 72
5-16-72

MISSISSIPPI
 BOARD OF WATER COMMISSIONERS
 416 North State Street
 Jackson, Mississippi 39201

CODED

WATER WELL DRILLERS LOG

5-16- 19 72 NEEL LUMPKIN WELL DRILLING SERVICE (county well located)
 date well completed CARRIERE, MISS. P. O. BOX 117 Pearl River

LANDOWNER:	description of formations encountered	from	to
<u>George M. Govern</u> <u>Anchar Lake</u> <u>CARRIERE, Miss.</u> (mailing address)	<u>Surface clay</u> <u>& sand</u> <u>(in good)</u>	<u>0</u>	<u>10</u> <u>45</u>
WELL LOCATION: sec <u>8</u> T <u>5th</u> R <u>16th</u> <u>3</u> miles <u>E</u> of <u>CARRIERE</u> (distance) (direction) (nearest town)	<u>Blue clay</u> <u>Good sand</u>	<u>45</u>	<u>150</u> <u>170</u>
WELL PURPOSE: <u>Camp site</u> (home, irrigation, municipal, industrial)			
WELL COMPLETION DATA:			
(1) diameter (inches) <u>2"</u>			
(2) total depth (feet) <u>170</u>			
(3) static water level (feet) <u>50</u> below above top of ground.			
(4) casing <u>galv.</u> (material), (depth) <u>2"</u> (size) If telescope see back.			
(5) screen <u>5'</u> (length), (depth to top) <u>2"</u> (size), <u>St. Steel</u> (material)			
(6) pump <u>1 HP</u> (HP), <u>600 gpm</u> (yield gpm), <u>electric</u> (type power)			
(7) electric log <u>no</u> (yes or no)			
(organization running log)			
(8) how well bottom plugged <u>Sand</u> <u>shark</u>			
DRILLERS REMARKS:			


CODED

MAY 24 1972

MISS. Bd. OF
 WATER COMM.

If well telescopes please sketch and show depths.

GROUND LEVEL

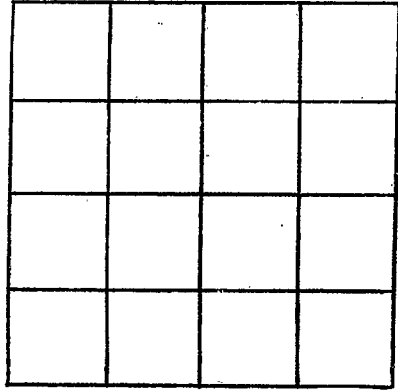

SECTION _____

Please indicate well location X.

ADDITIONAL INFORMATION

If more than one screen,
show locations of each on sketch.