

PEARL RIVER
V 75
6-4-72

MISSISSIPPI
 BOARD OF WATER COMMISSIONERS
 416 North State Street
 Jackson, Mississippi 39201

CODED

WATER WELL DRILLERS LOG

6-4-72 date well completed 1972 Penton Well Serv firm name Pearl River county well located

LANDOWNER: Mrs. Roland Spiers
Mr. Neill Miss
 (mailing address)

WELL LOCATION:
 sec. 2 T 5 S R 16 W
1/2 miles East of Miller
 (distance) (direction) (nearest town)

WELL PURPOSE: Home
 (home, irrigation, municipal, industrial)

WELL COMPLETION DATA: 4 1/2

- (1) diameter (inches) 2
- (2) total depth (feet) 594
- (3) static water level (feet) 18 below top of ground.
- (4) casing Galv. 584
 (material) (depth)
2 if telescope see back.
 (size)
- (5) screen 10 584
 (length) (depth to top)
2 S. Steel
 (size) (material)
- (6) pump ✓ ✓
 (HP) (yield gpm)
✓
 (type power)
- (7) electric log NO
 (yes or no)
 (organization running log)
- (8) how well bottom plugged Ball Valve

description of formations encountered	from	to
	Surface Clay	0
Sand	30	48
White Clay	48	65
Blue Clay	65	146
Sand	146	187
Blue Clay	187	538
Sand	538	594

CODED


1972
 1972

DRILLERS REMARKS:

M/S

If well telescopes please sketch and show depths.

GROUND LEVEL

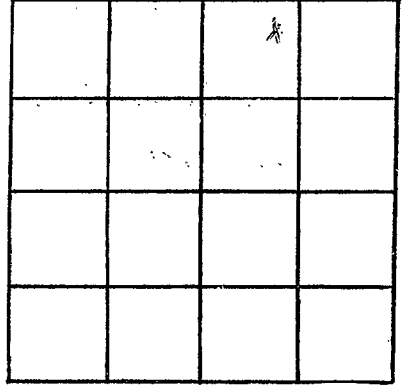

SECTION 2

Please indicate well location X.

ADDITIONAL INFORMATION

If more than one screen,
show locations of each on sketch.