

**PEARL RIVER**  
**V 76**  
**6-16-72**

MISSISSIPPI  
 BOARD OF WATER COMMISSIONERS  
 416 North State Street  
 Jackson, Mississippi 39201

**CODED**

**WATER WELL DRILLERS LOG**

6-16 1972 Penton Well Serv Pearl River  
 date well completed firm name county well located

LANDOWNER: Dr. Huebec

description of formations encountered

from to

Anchor Lake

Surface Clay

0 16

Carriere MISS

Sand

16 45

(mailing address)

White Clay

45 73

WELL LOCATION:

Blue Clay

73 190

sec. 9 T. 5 W. R. 16 W.  
3 miles East of Carriere  
 (distance) (direction) (nearest town)

Sand

190 218

Blue Clay

218 365

Sand

365 400

WELL PURPOSE: Home  
 (home, irrigation, municipal, industrial)

WELL COMPLETION DATA: 4 1/2

(1) diameter (inches) 2

(2) total depth (feet) 400

(3) static water level (feet) 20 below above top of ground.

(4) casing Galv, 390,  
 (material) (depth)

2 if telescope see back.  
 (size)

(5) screen 10, 390  
 (length) (depth to top)

2, 3. Steel  
 (size) (material)

(6) pump 1/2 9  
 (HP) (yield gpm)

6kw  
 (type power)

(7) electric log NO  
 (yes or no)

(organization running log)

(8) how well bottom plugged Bad. Value


**CODED**

JUL 7 1972

DRILLERS REMARKS:

If well telescopes please sketch and show depths.

GROUND LEVEL

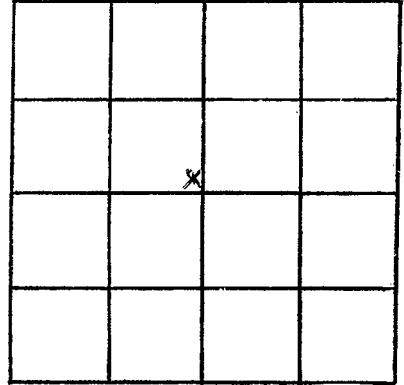

SECTION 9

Please indicate well location X.

ADDITIONAL INFORMATION

If more than one screen, show locations of each on sketch.