

**Pearl River**  
**V 78**  
**7-21-72**

MISSISSIPPI  
 BOARD OF WATER COMMISSIONERS  
 416 North State Street  
 Jackson, Mississippi 39201

WATER WELL DRILLERS LOG

**CODED**

WELL LUMPKET

DRILLING SERVICE

BOX 117

CARRIER, MISS

*Pearl River*

7-21 1972  
 date well completed

county well located

LANDOWNER:	description of formations encountered	from	to
<i>Coleman Tarnok Slidell, La.</i>	<i>Surface clay</i>	<i>0</i>	<i>10</i>
<i>or Carriere Miss, Route 1 (mailing address)</i>	<i>Surface sand</i>	<i>10</i>	<i>60</i>
WELL LOCATION: sec. <i>11</i> T. <i>5</i> S. R. <i>16</i> W.	<i>Blue clay</i>	<i>60</i>	<i>220</i>
<i>6</i> miles <i>East</i> of <i>Carriere</i> (distance) (direction) (nearest town)	<i>Good sand</i>	<i>220</i>	<i>305</i>
WELL PURPOSE: <i>nursery-home</i> (home, irrigation, municipal/industrial)			
WELL COMPLETION DATA:			
(1) diameter (inches) <i>14 7/8 of 4"</i>			
(2) total depth (feet) <i>147 1/2"</i>			
(3) static water level (feet) <i>73</i> below top of ground.			
(4) casing <i>galv.</i> (material), (depth) <i>4" x 2"</i> (size) if telescope see back.			
(5) screen <i>10'</i> (length), (depth to top) <i>2"</i> (size), <i>Steel (Johnson)</i> (material)			
(6) pump <i>5 Subm 80</i> (HP), (yield gpm) <i>electric</i> (type power)			
(7) electric log <i>no</i> (yes or no)			
(organization running log)			
(8) how well bottom plugged <i>Johnson back pressure valve</i>			
DRILLERS REMARKS:			


**CODED**

301 27 1972

MISS. Bd. of WATER COMM.

If well telescopes please sketch and show depths.

GROUND LEVEL

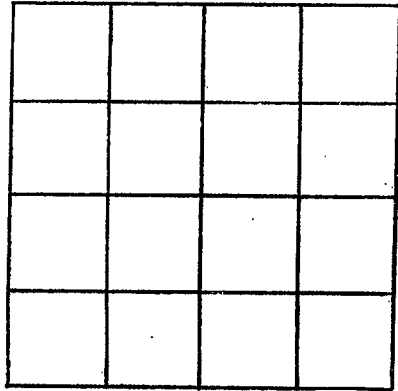

SECTION \_\_\_\_\_

Please indicate well location X.

ADDITIONAL INFORMATION

Lined area for additional information, consisting of approximately 20 horizontal lines.

If more than one screen, show locations of each on sketch.