

PEARL RIVER
V 79 GUDED
8-7-72

MISSISSIPPI
BOARD OF WATER COMMISSIONERS
 416 North State Street
 Jackson, Mississippi 39201

WATER WELL DRILLERS LOG

8-7 1972 Peartons Well Serv Pearl River
 date well completed firm name county well located

LANDOWNER: Donald Winidham
2615 Nina Dr-
Picayune Miss-
 (mailing address)

WELL LOCATION:
 sec 8 T 5 S R 16 E
2 miles East of Carriere
 (distance) (direction) (nearest town)

WELL PURPOSE: Home
 (home, irrigation, municipal, industrial)

description of formations encountered	from	to
<u>Surface Clay</u>	<u>0</u>	<u>20</u>
<u>Red Sand</u>	<u>20</u>	<u>55</u>
<u>White Clay</u>	<u>55</u>	<u>70</u>
<u>Blue Clay</u>	<u>70</u>	<u>300</u>
<u>Sand</u>	<u>300</u>	<u>344</u>

WELL COMPLETION DATA: 4 1/2

(1) diameter (inches) 2

(2) total depth (feet) 344

(3) static water level (feet) 69 below top of ground.

(4) casing Galv., 334
 (material) (depth)

2"
 (size) If telescope see back.

(5) screen 10, 334
 (length) (depth to top)

2, S. Steel
 (size) (material)

(6) pump 1, 9
 (HP) (yield gpm)

Eloc
 (type power)

(7) electric log No
 (yes or no)

(organization running log)

(8) how well bottom plugged B.W. Valve


AUG 23 1972

MISS. B.D. U.I. WATER COMMISSION

DRILLERS REMARKS:

If well telescopes please sketch and show depths.

GROUND LEVEL

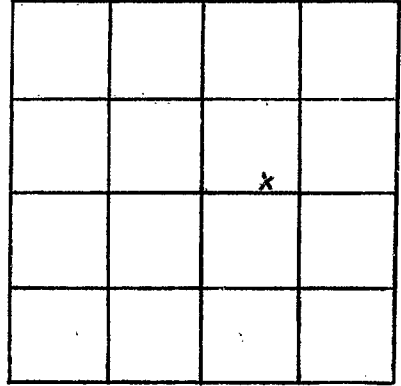

SECTION 8

Please indicate well location X.

ADDITIONAL INFORMATION

If more than one screen,
show locations of each on sketch.