

Pearl River  
V 81  
10-4-72

MISSISSIPPI  
 BOARD OF WATER COMMISSIONERS  
 416 North State Street  
 Jackson, Mississippi 39201

WATER WELL DRILLERS LOG

~~SMITH~~ LUMPKIN WELL DRILLING SERVICE  
 P. O. BOX 117  
 CARROLL, MISS.

Pearl River  
 county well located

10-4 1972  
 date well completed

LANDOWNER: A. J. Brooks  
Room 112B  
225 Baronne St.  
N. O. La. 70112  
 (mailing address)

description of formations encountered

	from	to
Surface clay	0	20
Surface sand	20	110
Blue clay	110	160
Good sand	160	210
Blue clay	210	340
Good sand	340	500
Blue clay	500	650
Good sand	650	750
Blue clay & shale	750	1190
Fine to better sand	1190	1281

WELL LOCATION:  
 sec. 3 T 5 S R. 16 W  
6 miles NE of Carrriere  
 (distance) (direction) (nearest town)

WELL PURPOSE:  
 (home, irrigation, municipal, industrial)

WELL COMPLETION DATA:

(1) diameter (inches) 2"

(2) total depth (feet) 1281'

(3) static water level (feet) \_\_\_\_\_ below above top of ground.

(4) casing galv. \_\_\_\_\_ (material) \_\_\_\_\_ (depth) \_\_\_\_\_  
2" If telescope see back.  
 (size)

(5) screen 20' \_\_\_\_\_ (length) \_\_\_\_\_ (depth to top)  
2" \_\_\_\_\_ (size) \_\_\_\_\_ (material)

(6) pump \_\_\_\_\_ (HP) \_\_\_\_\_ (yield gpm)  
 (type power)

(7) electric log no \_\_\_\_\_ (yes or no)

(organization running log)

(8) how well bottom plugged Sand-  
Shale


DRILLERS REMARKS:  
10 lbs. pressure

NOV 15 1972

MISSISSIPPI  
 BOARD OF WATER COMMISSIONERS

If well telescopes please sketch and show depths.

GROUND LEVEL

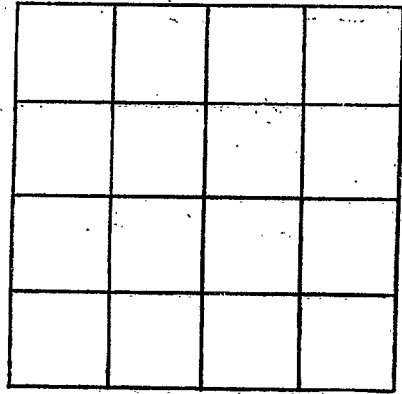

SECTION \_\_\_\_\_

Please indicate well location X.

ADDITIONAL INFORMATION

A series of horizontal lines for recording additional information, starting below the 'ADDITIONAL INFORMATION' header and extending to the bottom of the page.

If more than one screen, show locations of each on sketch.