

PEARL RIVER  
V 83  
11-25-72

MISSISSIPPI  
BOARD OF WATER COMMISSIONERS  
416 North State Street  
Jackson, Mississippi 39201

**CODED**

WATER WELL DRILLERS LOG

11/25/72 date well completed      72 Pearl River & Son firm name      Pearl River county well located


LANDOWNER: <u>Edgar Murray</u>	description of formations encountered	from	to
<u>B.T.1 Box</u>	<u>Red shale</u>	<u>0</u>	<u>30</u>
<u>Carriere Miss.</u>	<u>sand rocks</u>	<u>30</u>	<u>60</u>
(mailing address)	<u>Red shale</u>	<u>60</u>	<u>196</u>
	<u>Blue sand</u>	<u>196</u>	<u>222</u>
<b>WELL LOCATION:</b>			
sec. <u>20</u> T. <u>5</u> N. R. <u>16</u> E.			
<u>4</u> miles <u>E</u> of <u>Carriere</u>			
(distance) (direction) of (nearest town)			
<b>WELL PURPOSE:</b> <u>home</u>			
(home, irrigation, municipal, industrial)			
<b>WELL COMPLETION DATA:</b>			
(1) diameter (inches) <u>2 1/2</u>			
(2) total depth (feet) <u>222</u>			
(3) static water level (feet) <u>26</u> below above top of ground.			
(4) casing <u>galv.</u> <u>222</u>			
(material) (depth)			
<u>2 1/2"</u> If telescope see back.			
(size)			
(5) screen <u>2x5</u> <u>222</u>			
(length) (depth to top)			
<u>2 1/2"</u> <u>galv.</u>			
(size) (material)			
(6) pump <u>1</u> <u>360</u>			
(HP) (yield gpm)			
<u>Elect</u>			
(type power)			
(7) electric log <u>110</u>			
(yes or no)			
(organization running log)			
(8) how well bottom plugged <u>sand</u>			
<u>white</u>			
<b>DRILLERS REMARKS:</b>			

**CODED**

DEC 11 1972

If well telescopes please sketch and show depths.

GROUND LEVEL

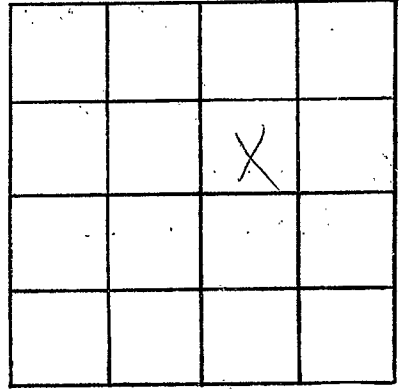

SECTION \_\_\_\_\_

Please indicate well location X.

ADDITIONAL INFORMATION

If more than one screen, show locations of each on sketch.